

FILED
GREENVILLE CO., S.C.

NOV 29 11 16 AM '85 S 1-58 E

107

108

DONNIE S. TANKERSLEY
R.M.C.



N 87-50 E 160.0

OLD LOT LINE 7


S 87-50 W 160.0

77

PT. 76

PT. 76

78

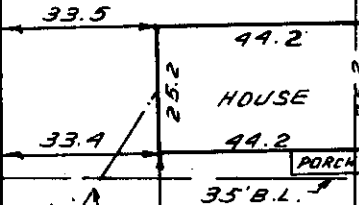

290' ± TO DUMONT AVE.

N 1-58 W 112.2

SANDRA STREET

NOV 29 1985
18433

12-F-14




THIS IS TO CERTIFY THAT THE PROPERTY SHOWN ON THIS PLAT WAS SURVEYED UNDER MY DIRECT SUPERVISION. PROPERTY LINES AND IMPROVEMENTS SHOWN ARE LOCATED CORRECTLY AND THAT NO VISIBLE ENCROACHMENTS EXIST UNLESS OTHERWISE SHOWN. THIS PROPERTY IS NOT LOCATED IN A DESIGNATED FLOOD HAZARD AREA.

STATE OF SOUTH CAROLINA
GREENVILLE COUNTY

FREELAND & ASSOCIATES
Engineers • Land Surveyors
318 WEST STONE AVENUE.
GREENVILLE, S.C.
(803) 271-4924

ROCKVALE
SEC. 1; PT. LOT 76 & LOT 77
PROPERTY OF
STAFFORD VERNALL BAKER, JR.
LUE FRANCIS BAKER

PLAT BOOK	88-108
DEED BOOK	1088-656
TAX MAP	WG 6-2-1-119
PARTY CHIEF	JCC
DRAWN	B.R.
DATE	11-27-85
DWG. NO.	14209

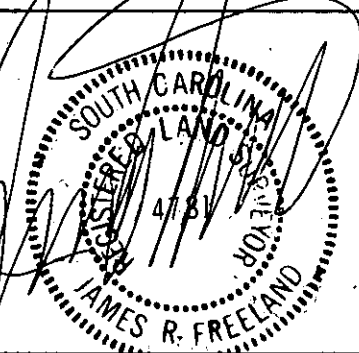

RLS: JAMES R. FREELAND
NO: 4781