

**NOTE :**


5' DRAINAGE & UTILITY  
EASEMENT ALONG  
ALL REAR AND SIDE LOT  
LINES.

PINEHURST DRIVE

18430

12-F-17

FILED 585  
NOV 29 12 21 PM '85  
GREENVILLE CO. S.C.  
DONNIE S. TANKERSLEY  
R.M.C.

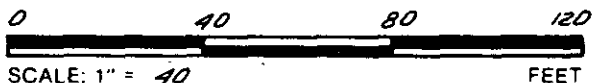

THIS IS TO CERTIFY THAT THE PROPERTY SHOWN ON THIS PLAT WAS SURVEYED UNDER MY DIRECT SUPERVISION. PROPERTY LINES AND IMPROVEMENTS SHOWN ARE LOCATED CORRECTLY AND THAT NO VISIBLE ENCROACHMENTS EXIST UNLESS OTHERWISE SHOWN. THIS PROPERTY IS NOT LOCATED IN A DESIGNATED FLOOD HAZARD AREA.

**STATE OF SOUTH CAROLINA  
GREENVILLE COUNTY**

PINE VALLEY ESTATES

SEC. 1 ; LOT 3

PROPERTY OF

LEE B. MOORE

DEBRA L. MOORE

**FREELAND & ASSOCIATES**  
Engineers • Land Surveyors  
316 WEST STONE AVENUE.  
GREENVILLE, S.C.  
(803) 271-4924

PLAT BOOK	MM @ 138
DEED BOOK	1137-798
TAX MAP	M 6.2-1-116
PARTY CHIEF	GP.
DRAWN	B.R.
DATE	11-27-85
DWG. NO.	14213

PLS: JAMES R. FREELAND  
NO: 4781