MICROFILMED

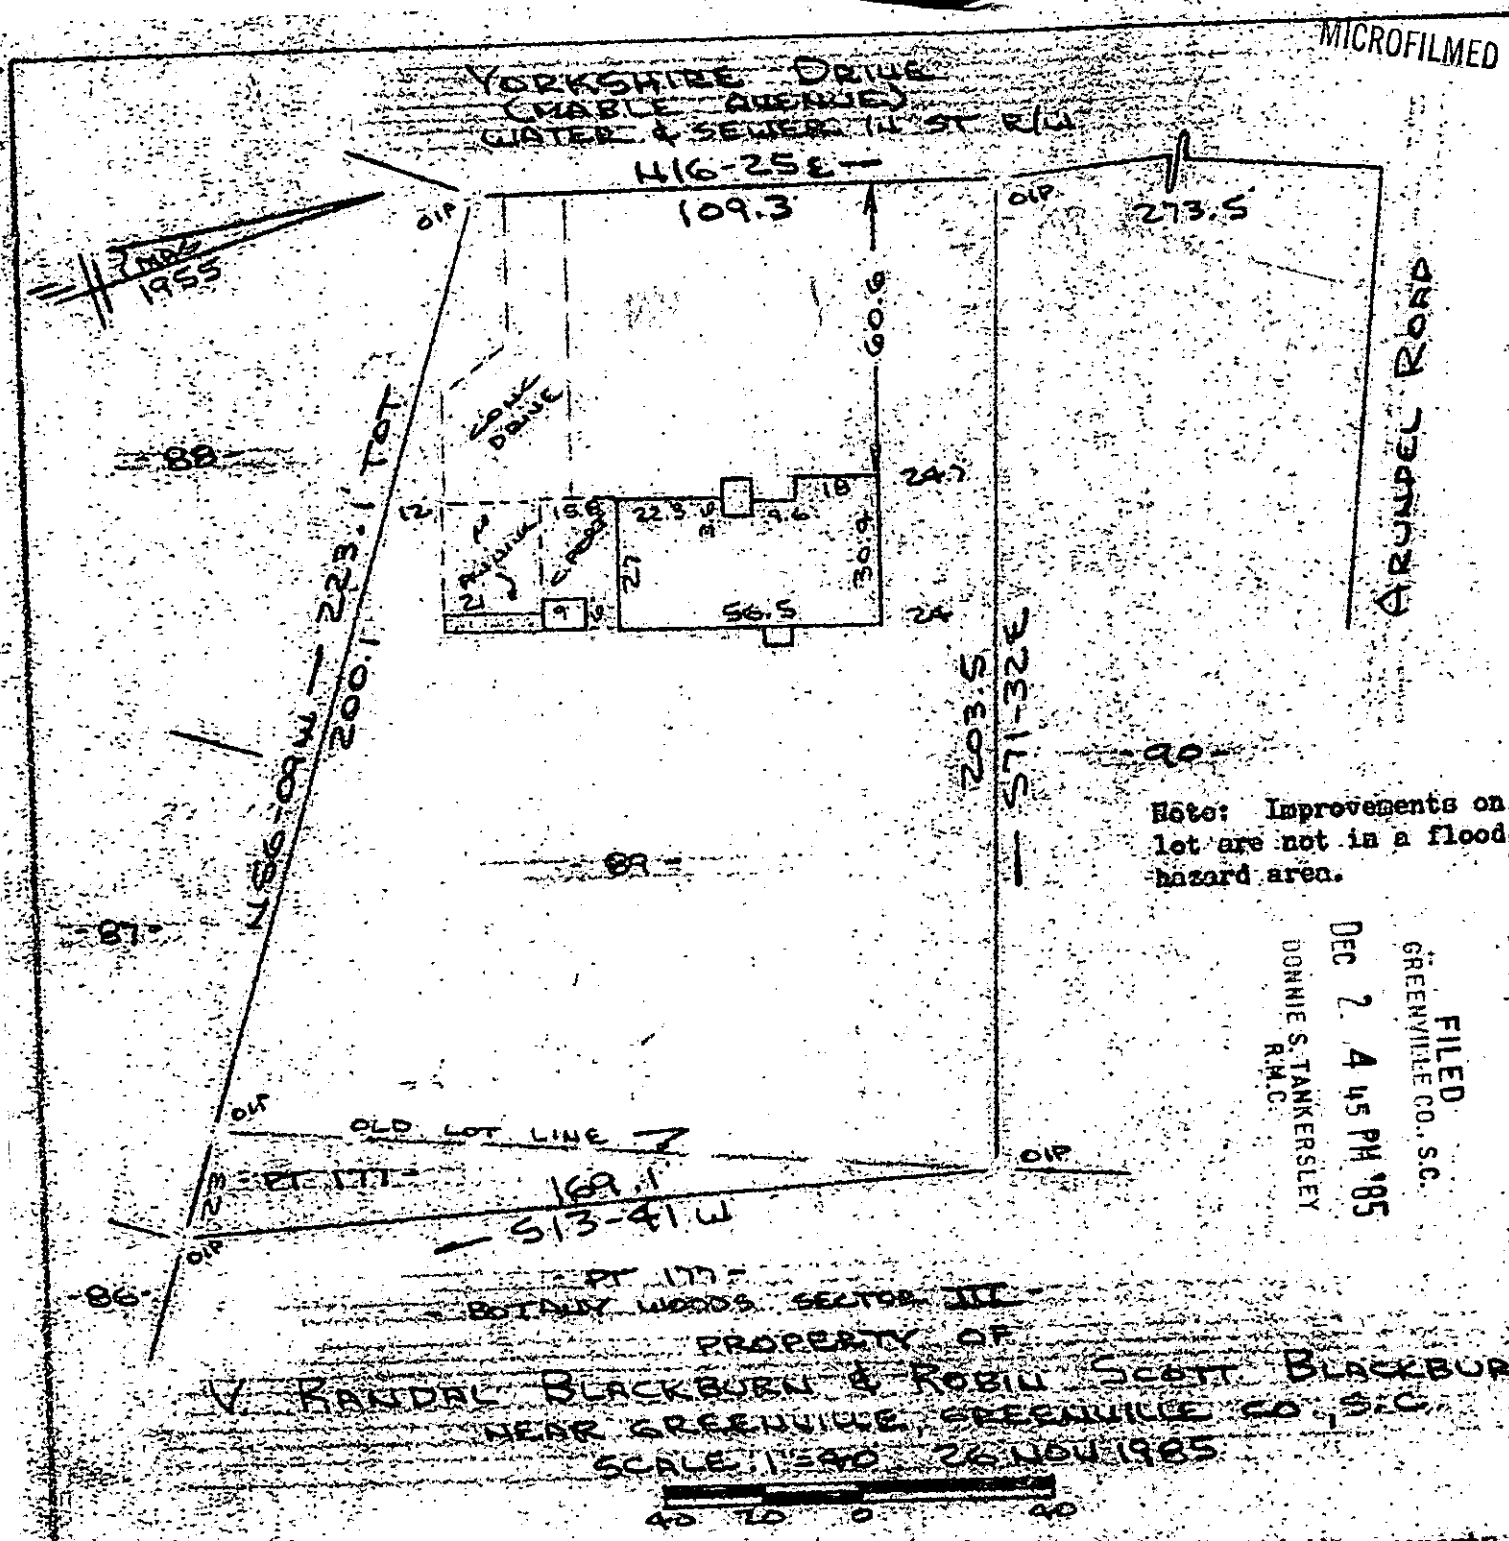

Note: Improvements on this lot are not in a flood hazard area.

FILED
GREENVILLE CO., S.C.
DEC 2 4 45 PM '85
DONNIE S. TANKERSLEY
R.M.C.

This is to certify that on the 26th day of November, 1985, I surveyed the property shown on this plat, being known as lot 89 on plat of JAMES H. FUNDS and recorded in the RMC Office Greenville County, S.C., in Plat Book TT Page 91 and also part of lot 177 on plat of BOTANY WOODS SECTOR IV and recorded in the RMC Office Greenville County, S.C., in Plat Book YY Page 23 and also Plat Book ZZ Page 111; and that the property lines, walls and buildings are as shown hereon, and that the walls and buildings located on said lot do not encroach or project on adjacent street or property, and that no adjacent walls or buildings encroach or project on said premises, and no power lines cross this property except as shown hereon.

Also being known as PROPERTY OF V. RANDAL BLACKBURN AND ROBIN SCOTT BLACKBURN and recorded in the RMC Office Greenville County, S.C., in Plat Book Page

18599

12F-25

CAROLINA SURVEYING CO.
Greenville, S. C.

R. B. Bruce
R.B. BRUCE, RLS 1952

Recordable Plat

P.B. 10-1-143 & P.B. 13-1-259