MICROFILMED

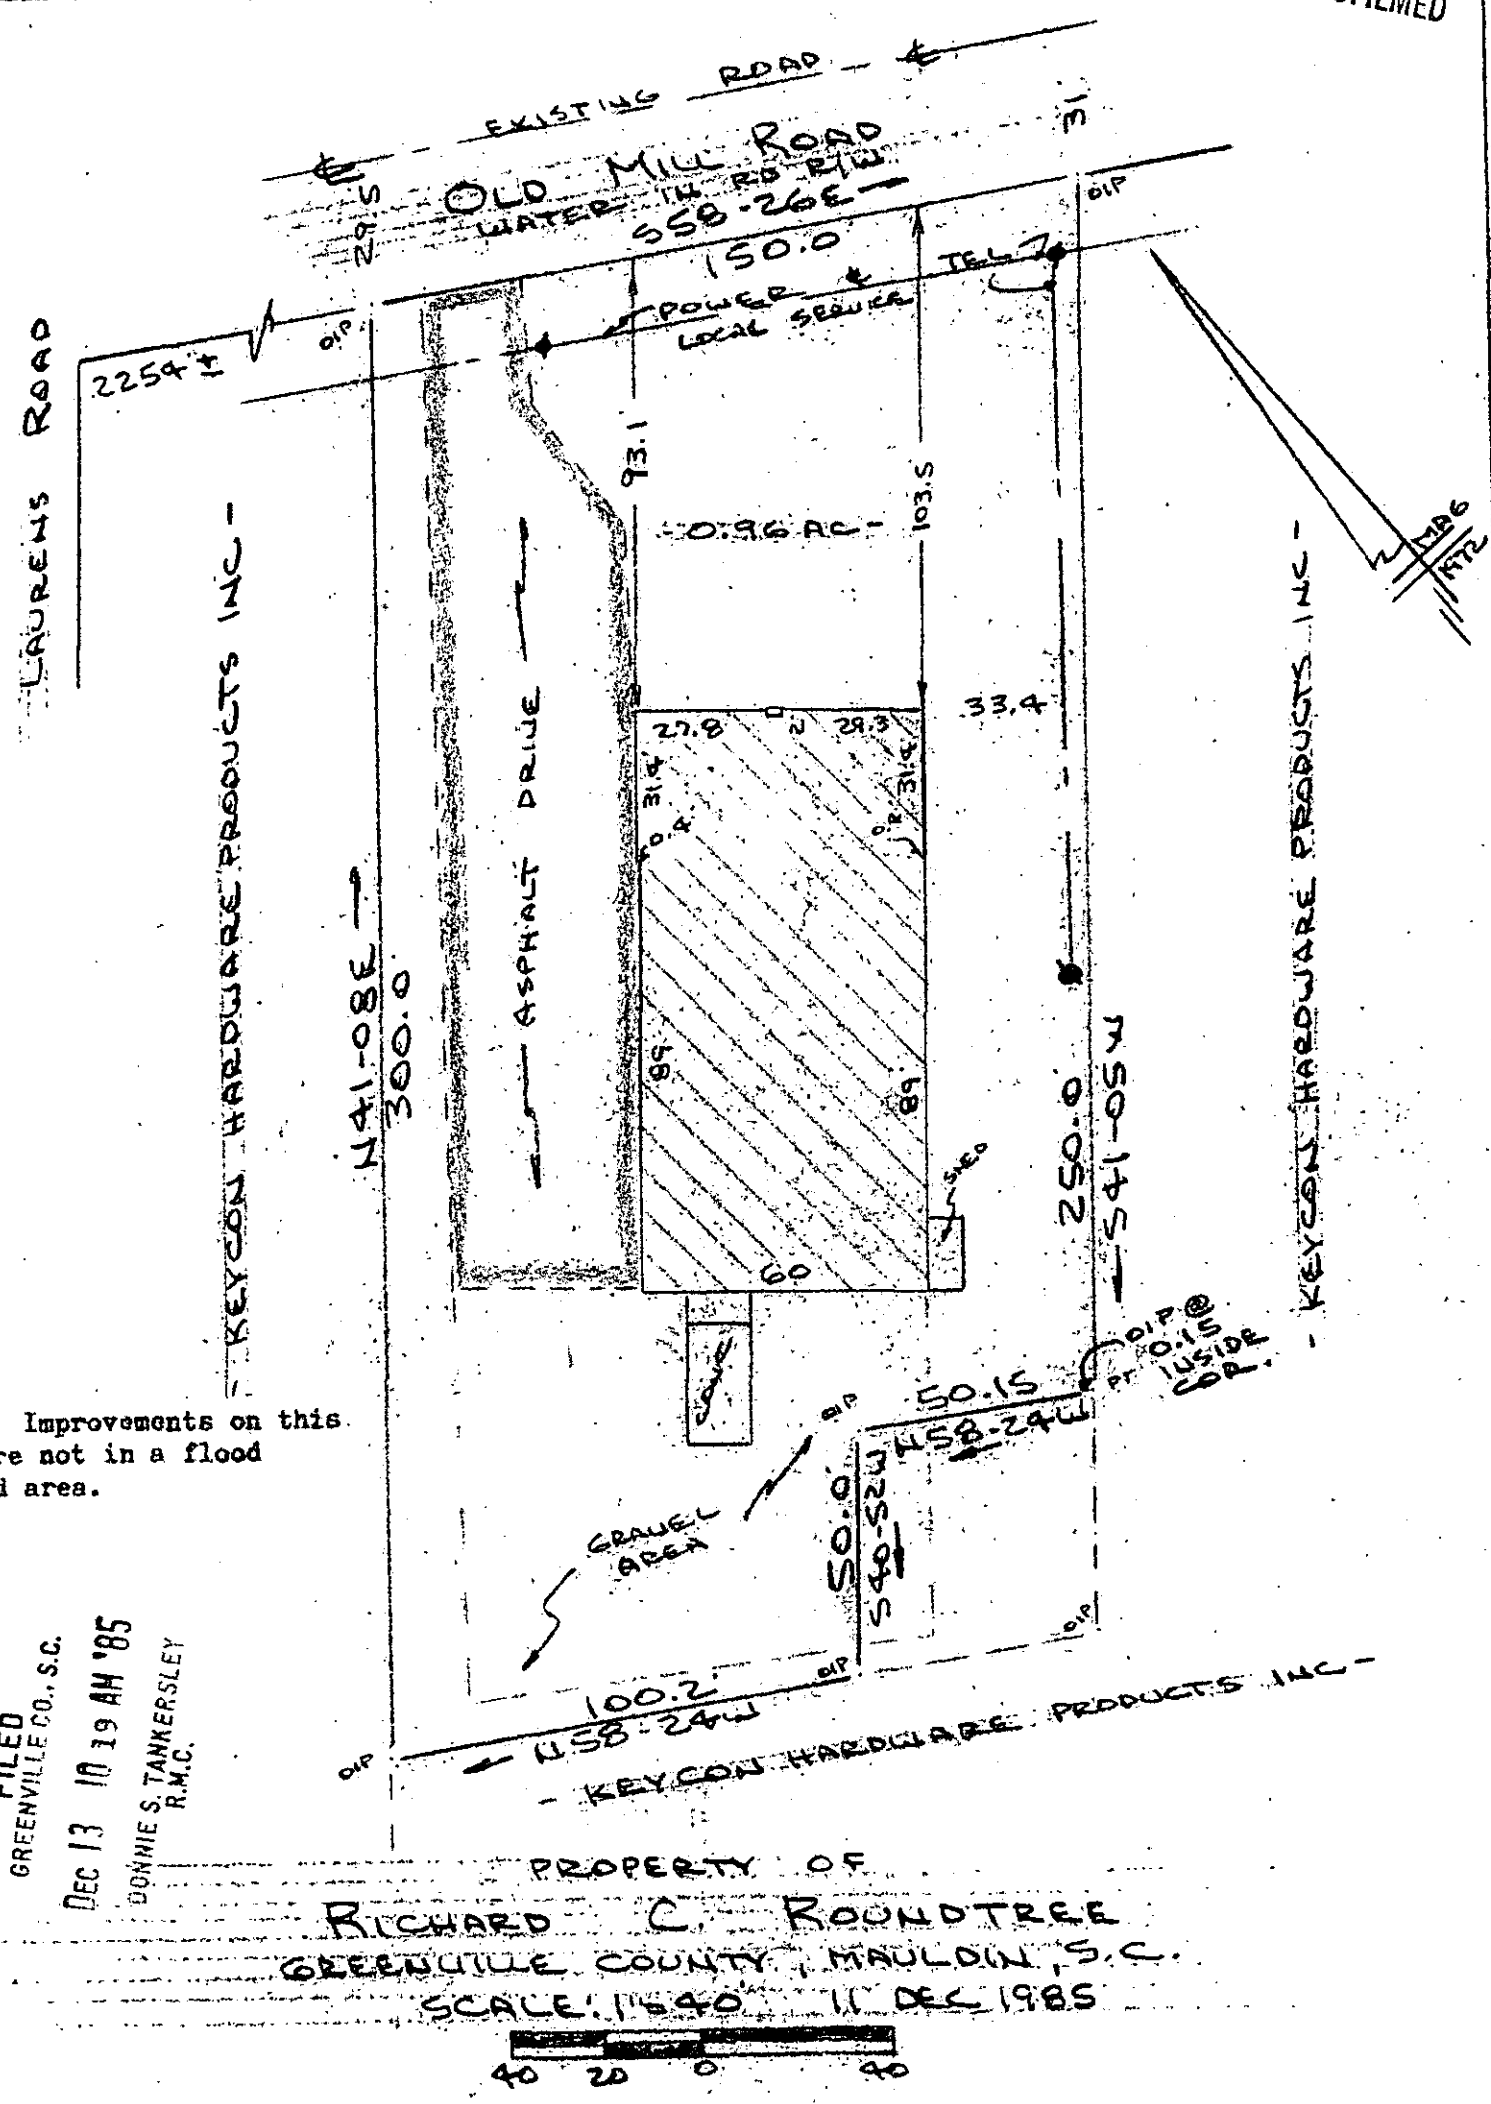

Note: Improvements on this lot are not in a flood hazard area.

FILED
GREENVILLE CO., S.C.
DEC 13 10 19 AM '85
DONNIE S. TANKERSLEY
R.M.C.

PROPERTY OF
RICHARD C. ROUNDTREE
GREENVILLE COUNTY, MAULDIN, S.C.
SCALE: 1"=40' 11 DEC 1985

40 20 0 40

This is to certify that on the 11th day of December, 1985, I surveyed the property shown on this plat, being known as 0.96 acres on plat of PROPERTY OF RICHARD C. ROUNDTREE and recorded in the RMC Office Greenville County, S. C., in Plat Book at Page and that the property lines, walls and buildings are as shown hereon, and that the walls and buildings located on said lot do not encroach or project on adjacent street or property, and that no adjacent walls or buildings encroach or project on said premises, and no power lines cross this property except as shown hereon.

12-F-67 19966

SOUTH CAROLINA REGISTERED 1952 SURVEYOR

R. B. Bruce, RLS # 1952

CAROLINA SURVEYING CO.
Greenville, S. C.

Recordable Plat

286/78&79A M8.4-1-6 3.00 8 1801