


MICROFILMED

THIRD WAY
WATER & SEWER IN ST. DIM

FILED
GREENVILLE CO., S.C.
DEC 13 4 02 PM '85
DONNIE S. TANKERSLEY
R.M.C.

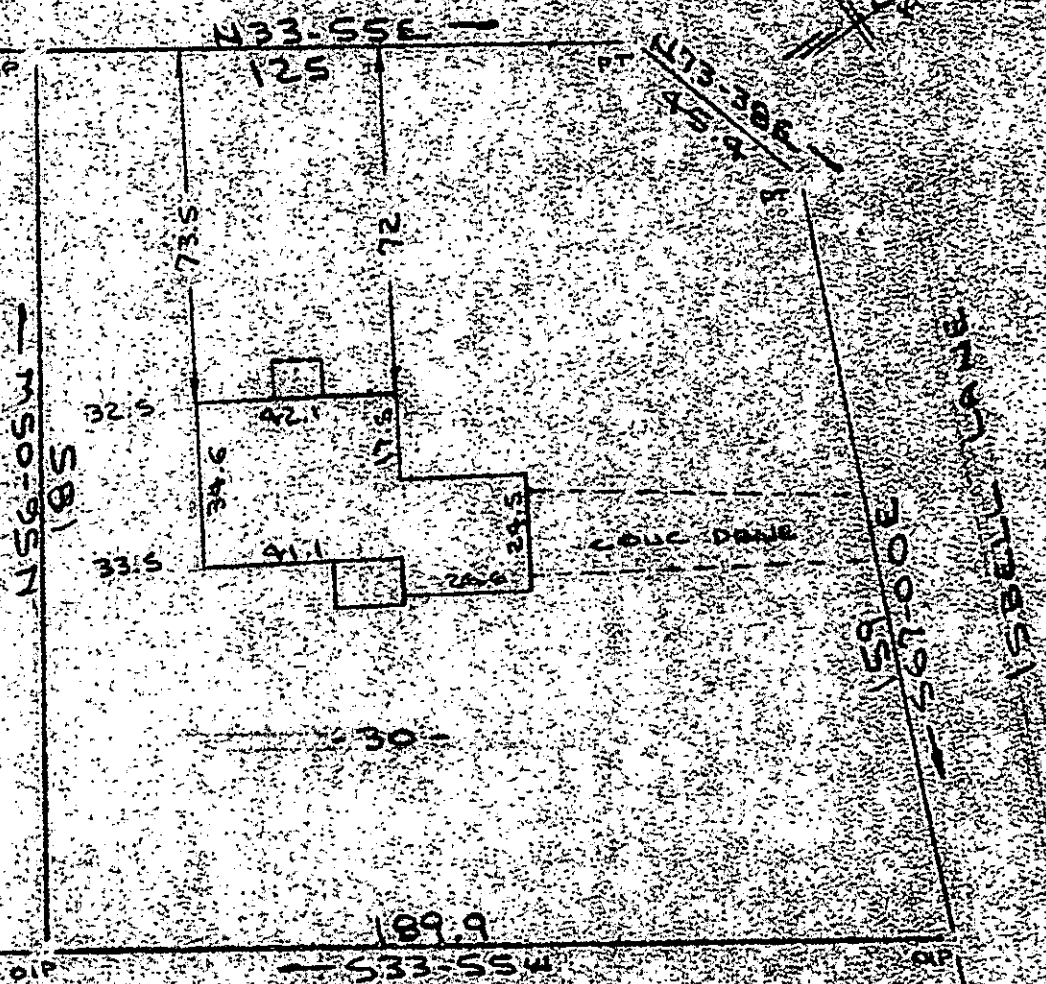

Note:
Improvements
on this lot
are not in a
flood hazard
area.

PROPERTY OF
WILLIAM D. THRAILKILL & LAURIE S. THRAILKILL
GREENVILLE, S.C.
SCALE 1" = 40' 16 DEC 1985

20031 ✓



This is to certify that on the 10th day of December, 1985, I surveyed the property shown on this plat, being known as lot 30 on plat of SECTION No. 2 PARKINS LAKE DEVELOPMENT and recorded in the REC Office Greenville County, S. C., in Plat Book "YY" at Page 93; and that the property lines, walls and buildings are as shown hereon, and that the walls and buildings located on said lot do not encroach or project on adjacent street or property, and that no adjacent walls or buildings encroach or project on said premises, and no power lines cross this property, except as shown hereon.

12F-72
DEC 13 1985

Recordable Plat

R. B. Bruce
R. B. Bruce, Dec 7 1985
CO. *R. B. Bruce*

CAROLINA SURVEYING
112 Mainly St.
Greenville, S.C.

500 8 91801

20017-a

M 11.1 - 1 - 34

21294