


PLAY GROUND



FILED
GREENVILLE CO., S.C.
DEC 17 2 51 PM '85
DONNIE S. JANKERLEY
R.M.C.

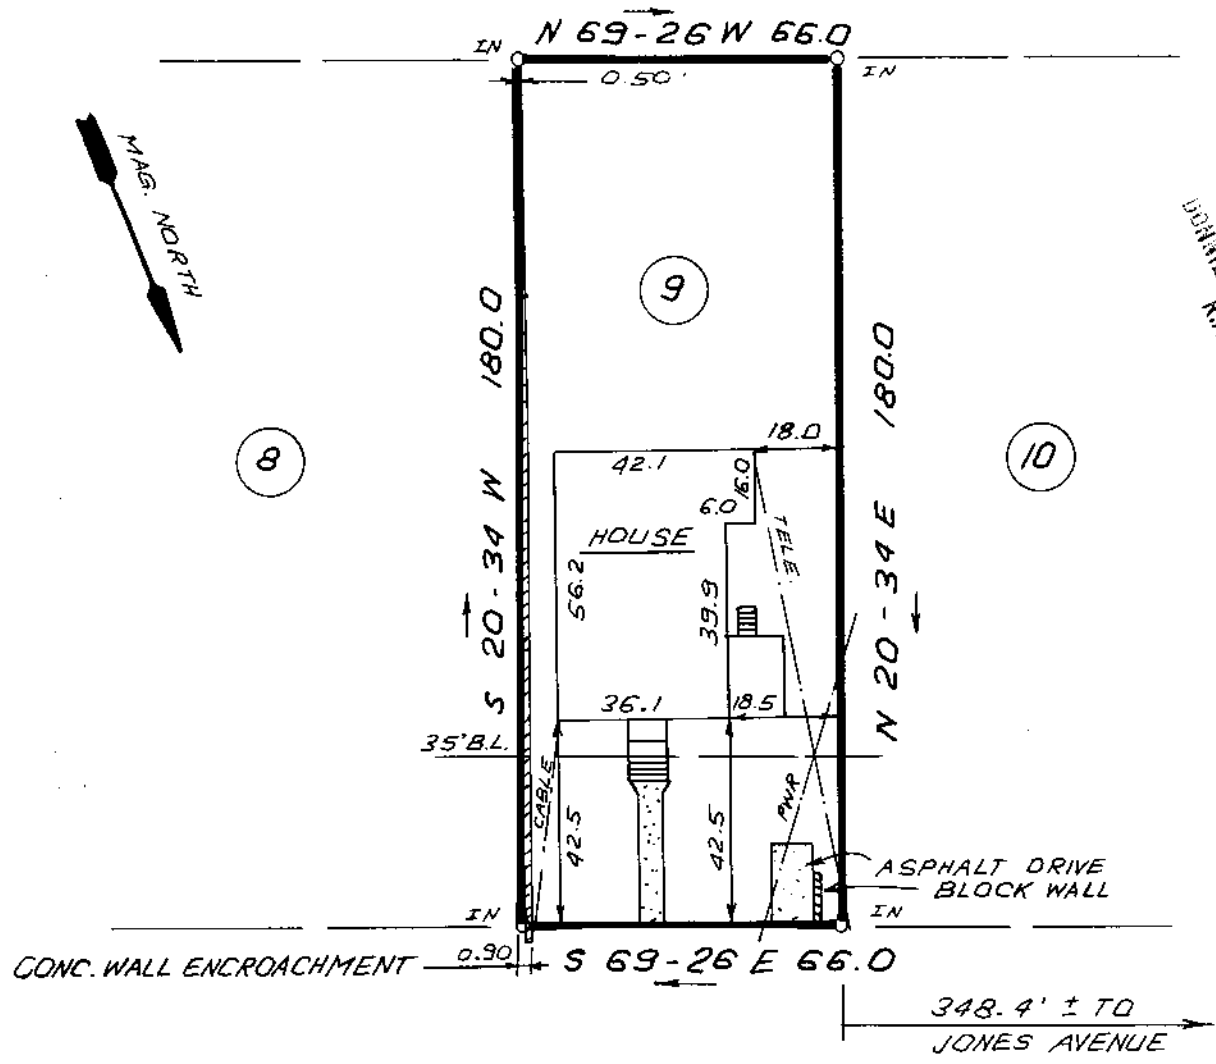


CLEVELAND STREET

DEC 17 1985



✓ 20340 12F-84

THIS IS TO CERTIFY THAT THE PROPERTY SHOWN ON THIS PLAT WAS SURVEYED UNDER MY DIRECT SUPERVISION PROPERTY LINES AND IMPROVEMENTS SHOWN ARE LOCATED CORRECTLY AND THAT NO VISIBLE ENCROACHMENTS EXIST UNLESS OTHERWISE SHOWN. THIS PROPERTY IS NOT LOCATED IN A DESIGNATED FLOOD HAZARD AREA

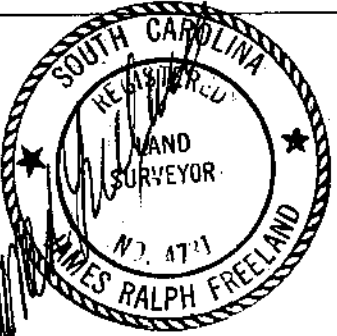

STATE OF SOUTH CAROLINA
GREENVILLE COUNTY

FREELAND & ASSOCIATES
Engineers • Land Surveyors
318 WEST STONE AVENUE,
GREENVILLE, S.C.
(803) 271-4924

PARRISH, GOWER & MARTIN PROP.
LOT 9
PROPERTY OF
WILLIAM A. COATES

RLS JAMES R. FREELAND
NO. 4781

PLAT BOOK	G - 197
DEED BOOK	599 - 364
TAX MAP	92 - 5 - 9
PARTY CHIEF	L. T.
DRAWN	I. R.
DATE	NOV. - 27 - 85
DWG NO	14215