MICROFILMED

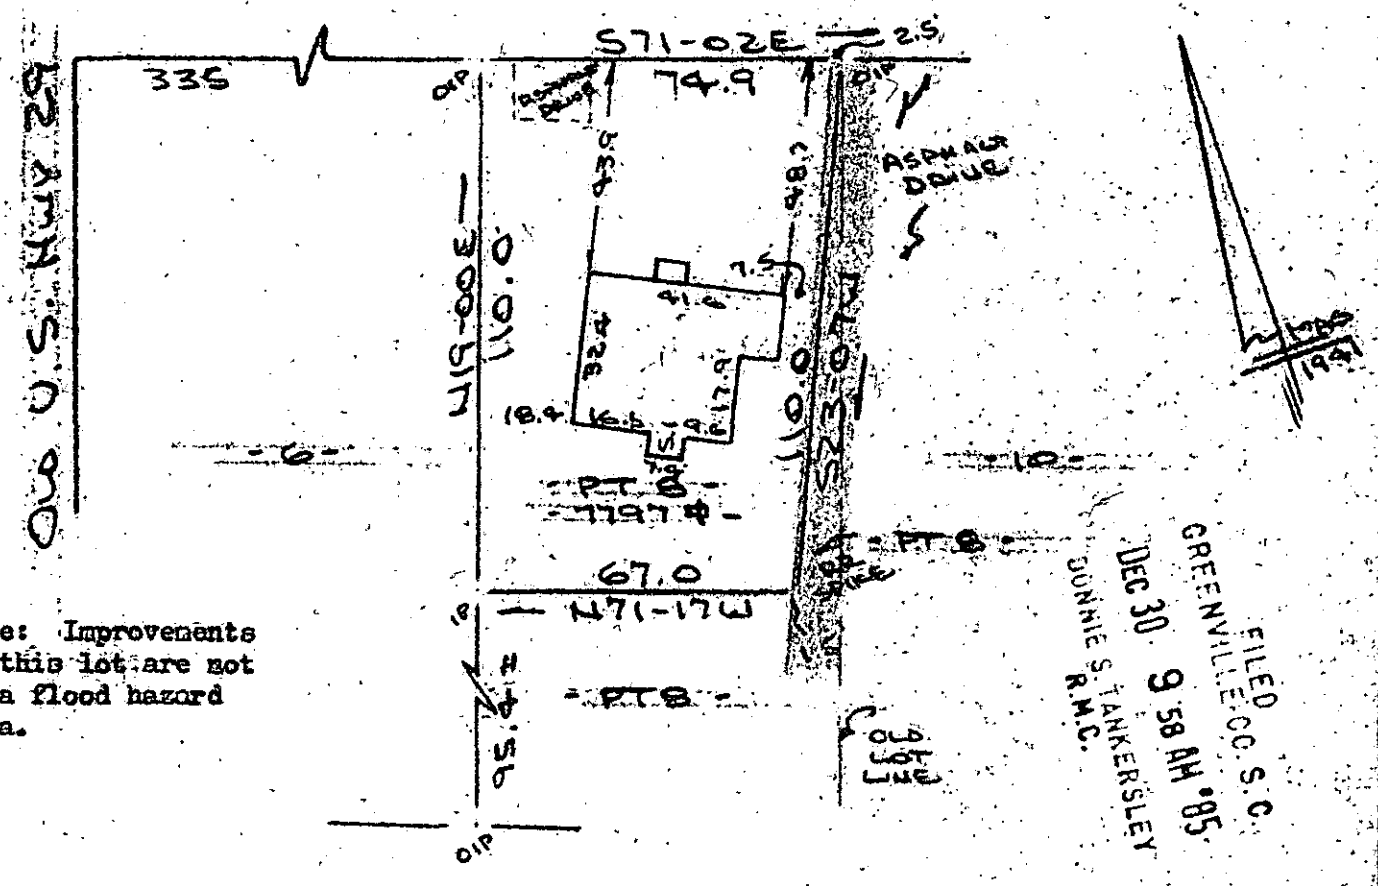

PROPERTY OF
MARIE L. STOLP
NEAR GREENVILLE, GREENVILLE CO., S.C.
SCALE: 1"=40' 29 JULY 1985

40 20 0 40

This is to certify that on the 29th day of July, 1985, I surveyed the property shown on this plat, being known as part of lot 8 on plat of J. E. HARMON and recorded in the RMC Office Greenville County, S. C., in Plat Book " L " at Page 153 and also known as PROPERTY OF MARIE L. STOLP and recorded in Plat Book at Page ; and that the property lines, walls and buildings are as shown hereon, and that the walls and buildings located on said lot do not encroach or project on adjacent street or property, and that no adjacent walls or buildings encroach or project on said premises, and no power lines cross this property except as shown hereon.

12-G-27 21525

R. B. Bruce

R. B. Bruce, RLS # 1952

DEC 30 1985

CAROLINA SURVEYING CO.
112 Manly St.
Greenville, S. C.

REGISTERED LAND SURVEYOR
R. B. BRUCE
No. 1952
STATE OF SOUTH CAROLINA

DE30 85

Recordable Plat