MICROFILMED

Note:
Improvements on this
lot are not in a flood
hazard area.

FILED
GREENVILLE CO. S.C.
DEC 30 4 57 PM '85
DONNIE S. TANKERSLEY
R.M.C.

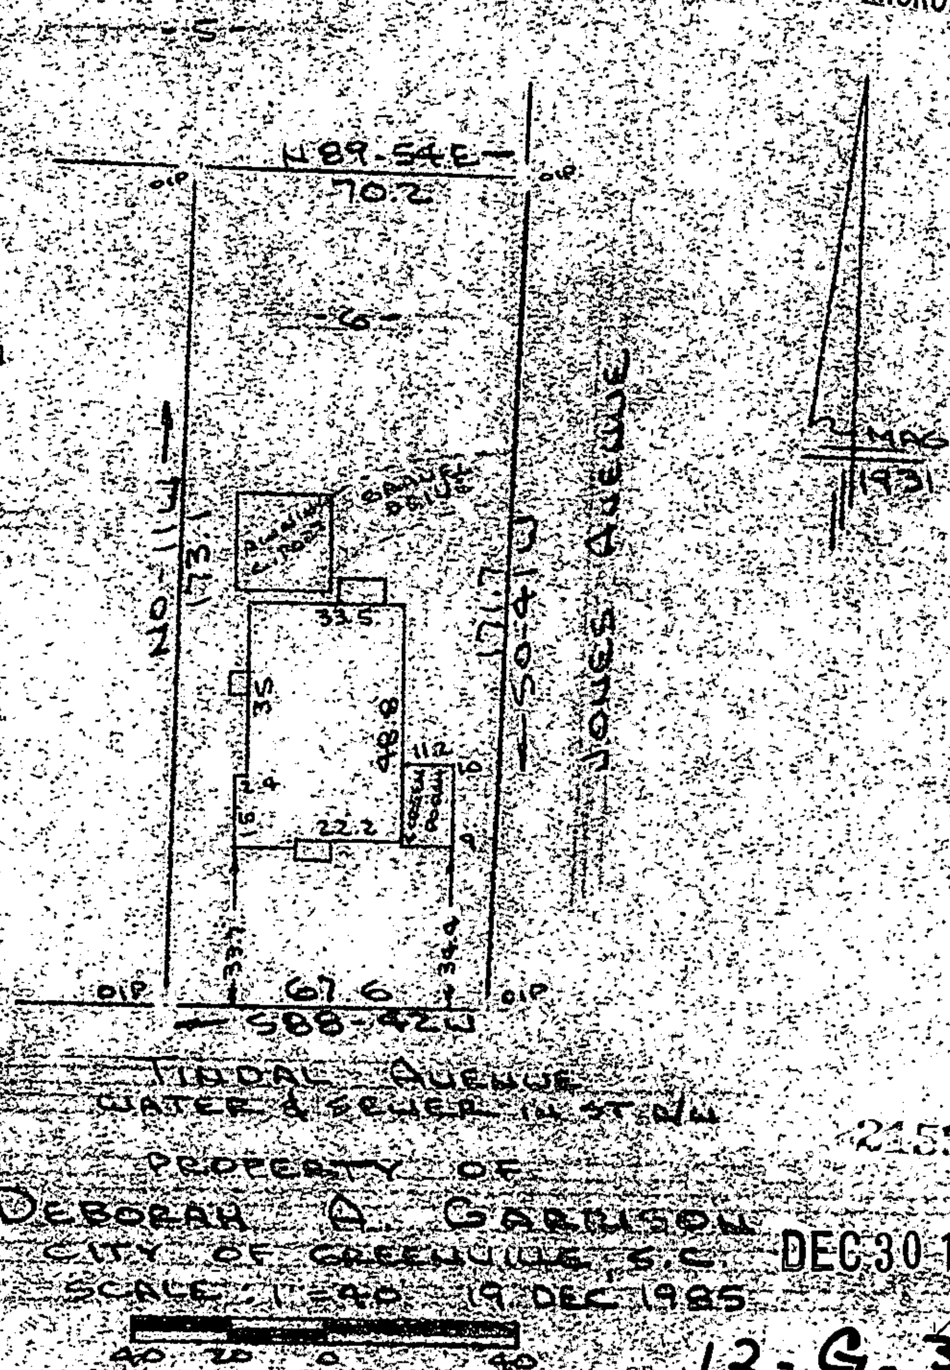

21596
DEC 30 1985
12-G-36

This is to certify that on the 19th day of December, 1985, I surveyed the property shown on this plat, being known as lot 6 on plat of ESTATE OF S. K. TINDAL and recorded in the RMC Office Greenville County, S. C., in Plat Book " H " at Pg. 235 & " Q " 247 and also known as PROPERTY OF DEBORAH A. GARRISON and recorded in Plat Book at Page ; and that the property lines, walls and buildings are as shown hereon, and that the walls and buildings located on said lot do not encroach or project on adjacent street or property, and that no adjacent walls or buildings encroach or project on said premises, and no power lines cross this property except as shown hereon.

R. B. Bruce

R. B. Bruce, RLS # 1952

R. B. Bruce

CAROLINA SURVEYING CO.
Greenville, S. C.

Recordable Plat

295/54