

FILED  
 GREENVILLE, CO. S.C.  
 DEC 31 12 18 PM '85  
 JOHNNIE S. TANKERSLEY  
 R.M.C.


Note:  
 Improvements on this  
 lot are not in a flood

Note: All side lot lines  
 to have 5' utility  
 easement and all rear  
 lot lines to have 10'  
 utility easement except  
 when shown otherwise on  
 plat.

Note: Improvements on  
 this lot are not in a  
 flood hazard area.

PROPERTY OF  
**ANITA BIBLE**

MAULDIN, S.C.  
 SCALE 1"=50' 26 DEC 1985

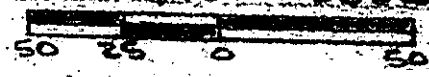

This is to certify that on the 26th day of December, 1985, I surveyed the property shown on this plat, being known as lot 14 on plat of VERDIN ESTATES MAP III and recorded in the REC Office Greenville County, S. C., in Plat Book "7 - X" at Page 17; and that the property lines, walls and buildings are as shown hereon, and that the walls and buildings located on said lot do not encroach or project on adjacent street or property, and that no adjacent walls or buildings encroach or project on said premises, and no power lines cross this property except as shown hereon.

DEC 31 1985 21713

12-G-40

*R. B. Bruce*  
 R. B. Bruce, PLS # 1952

CAROLINA SURVEYING CO.  
 Greenville, S. C.