


FILED
 GREENVILLE CO. S. C.
 Dec 31 3 28 PM '85
 DONNIE S. TANKERSLEY
 R.M.C.

HASTINGS CIRCLE

DEC 31 1985 ✓
 21875

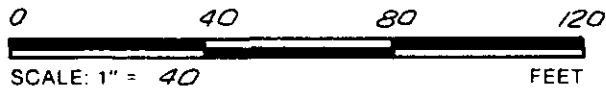

12-G-43

THIS IS TO CERTIFY THAT THE PROPERTY SHOWN ON THIS PLAT WAS SURVEYED UNDER MY DIRECT SUPERVISION. PROPERTY LINES AND IMPROVEMENTS SHOWN ARE LOCATED CORRECTLY AND THAT NO VISIBLE ENCROACHMENTS EXIST UNLESS OTHERWISE SHOWN. THIS PROPERTY IS NOT LOCATED IN A DESIGNATED FLOOD HAZARD AREA.

SOUTH CAROLINA
 REGISTERED LAND SURVEYOR
 JAMES R. FREELAND
 4781

RL: JAMES R. FREELAND
 NO: 4781

**STATE OF SOUTH CAROLINA
 GREENVILLE COUNTY**

CORAL RIDGE
PART LOT 39 & LOT 40
PROPERTY OF
GARY DALE ZIMMERMAN
JOLANNA M. ZIMMERMAN

FREELAND & ASSOCIATES
 Engineers • Land Surveyors
 318 WEST STONE AVENUE.
 GREENVILLE, S.C.
 (803) 271-4924

PLAT BOOK	XX - 119
DEED BOOK	798 - 13
TAX MAP	T 31 - 2 - 43
PARTY CHIEF	J.E.C. & G.P.
DRAWN	I.R.
DATE	NOV. - 15 - 85
DWG. NO.	14149