MICROFILMED

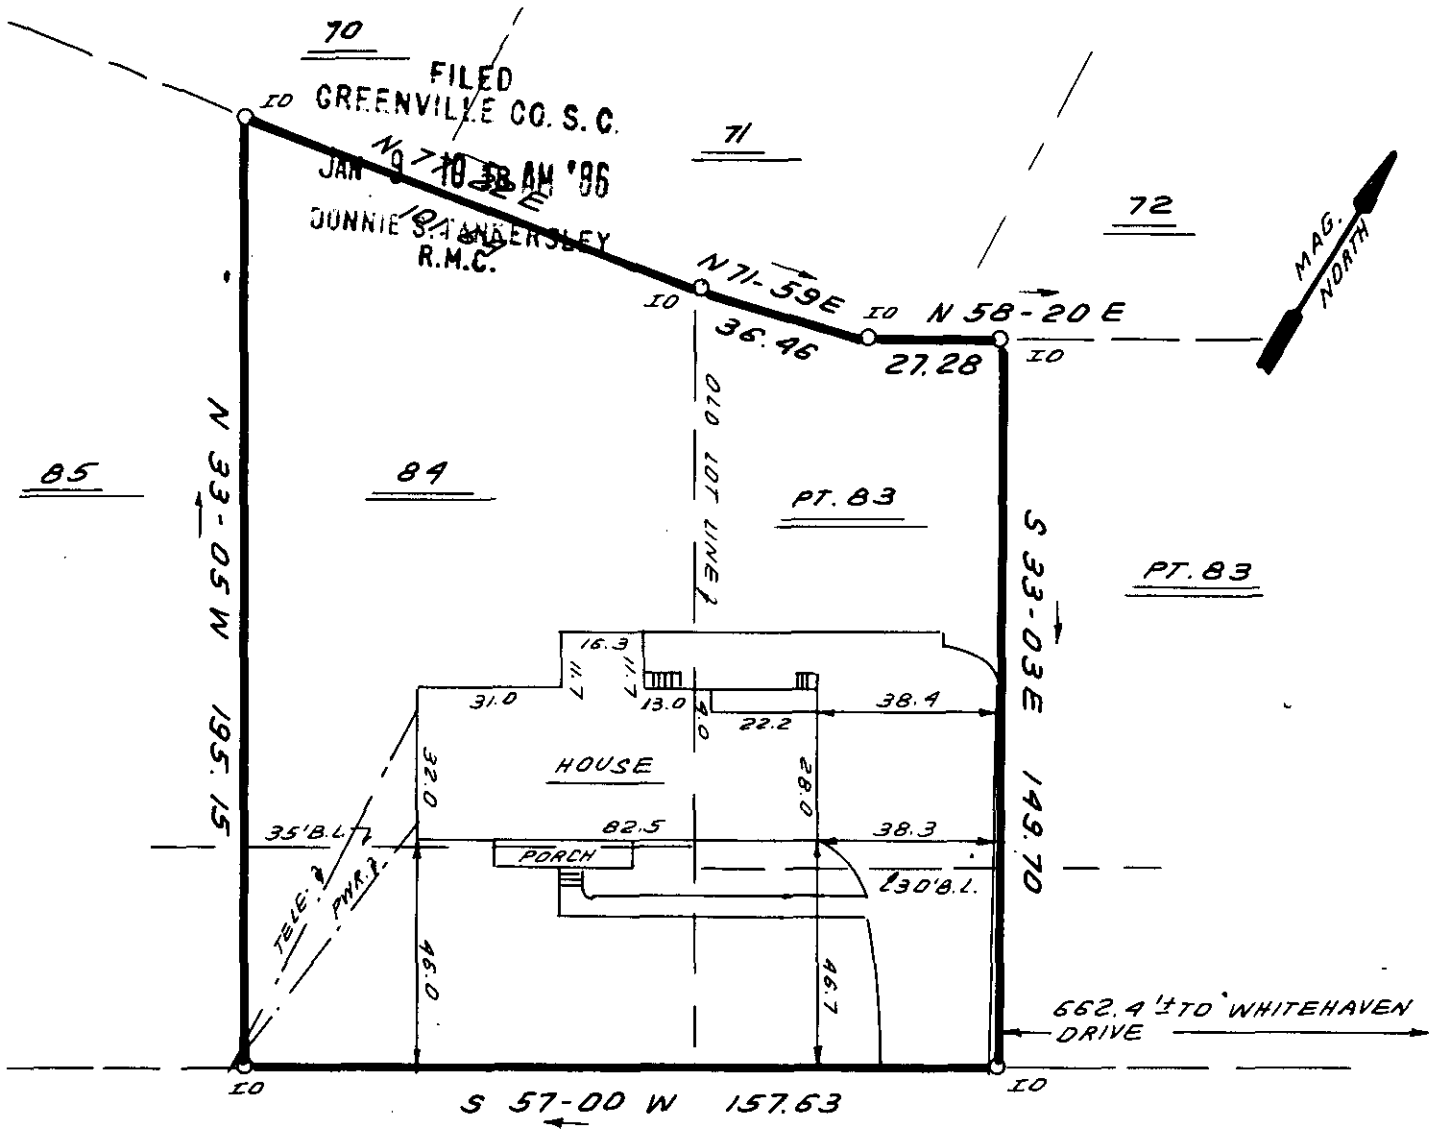

JAN 9 1986

12-6-79

0 40 80 120

SCALE 1" = 40 FEET

22786

THIS IS TO CERTIFY THAT THE PROPERTY SHOWN ON THIS PLAT WAS SURVEYED UNDER MY DIRECT SUPERVISION PROPERTY LINES AND IMPROVEMENTS SHOWN ARE LOCATED CORRECTLY AND THAT NO VISIBLE ENCROACHMENTS EXIST UNLESS OTHERWISE SHOWN. THIS PROPERTY IS NOT LOCATED IN A DESIGNATED FLOOD HAZARD AREA

SOUTH CAROLINA REGISTERED LAND SURVEYOR 4781 JAMES R. FREELAND

RLS JAMES R. FREELAND

NO 4781

STATE OF SOUTH CAROLINA
GREENVILLE COUNTY

WESTCLIFFE
PT. LOT 83 & LOT 84
PROPERTY OF
KONSTATINOS DEMAS

FREELAND & ASSOCIATES
Engineers • Land Surveyors
318 WEST STONE AVENUE.
GREENVILLE, S.C.
(803) 271-4924

PLAT BOOK	11A - 75
DEED BOOK	1230 - 507
TAX MAP	B 3.2 -5-117
PARTY CHIEF	JCC
DRAWN	BR
DATE	12-22-85
DWG. NO.	14340

THE PRINT MACHINE, INC. N53007