
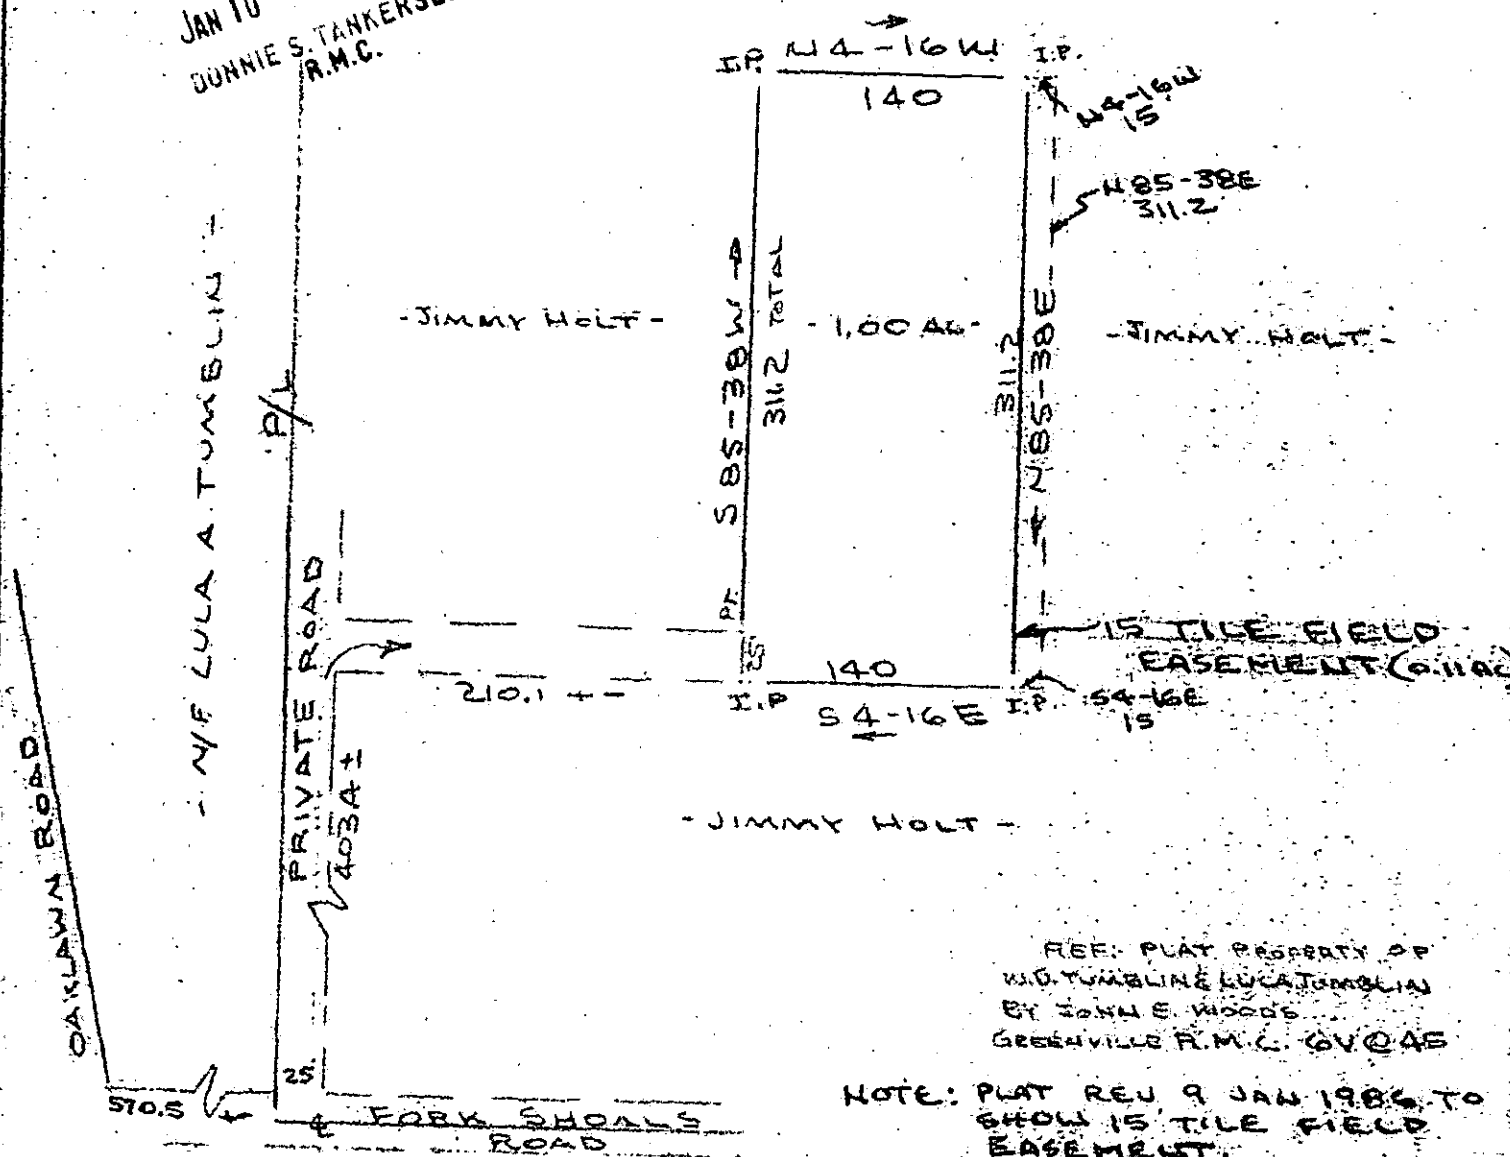


FILED  
GREENVILLE CO. S. C.  
JAN 10 1 39 PM '86  
DONNIE S. TANKERSLEY  
R.M.C.

MAG 1970

- JIMMY HOLT -

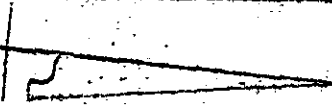


REF: PLAT PROPERTY OF  
BY JOHN E. WOODS  
GREENVILLE R.M.C. 6V@45

NOTE: PLAT REV 9 JAN 1986 TO  
SHOW 15 TILE FIELD  
EASEMENT.

JAN 10 1986

SURVEY FOR  
DONNIE R. SAXON & KATHY H. SAXON  
GREENVILLE CO. S.C. JAN 10 1986

12 G - 89 22997 ✓

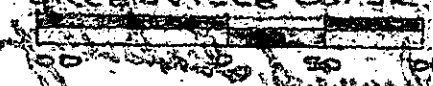


SCALE 1" = 100'

REV. 9 JAN 1986

LOCATION MAP NO SCALE

I Certify That The Ratio Of Precision Of The Field Survey  
Is  $\sqrt{5000}$  As Shown Hereon And That The Area  
Determined By D.M.D. Method Of Area Calculations.

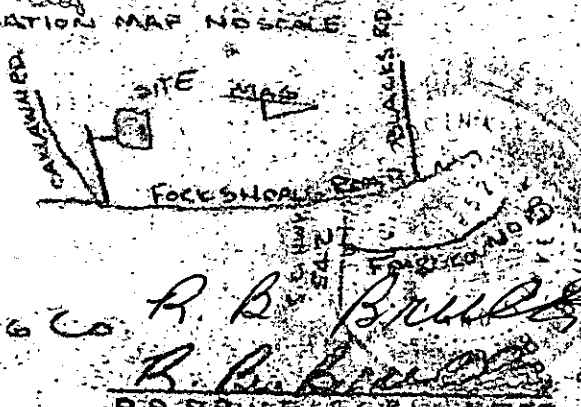

CAROLINA SURVEYING CO.  
112 MANLY STREET  
GREENVILLE S.C.

R. B. Bruce  
R. B. Bruce  
R.B. BRUCE 66251927

Recordable Plat

300 e 1801