


MICROFILMED

FILED
GREENVILLE CO. S.C.
MAR 31 4 08 PM '86
JUNNIE S. TANKERSLEY
R.M.G.

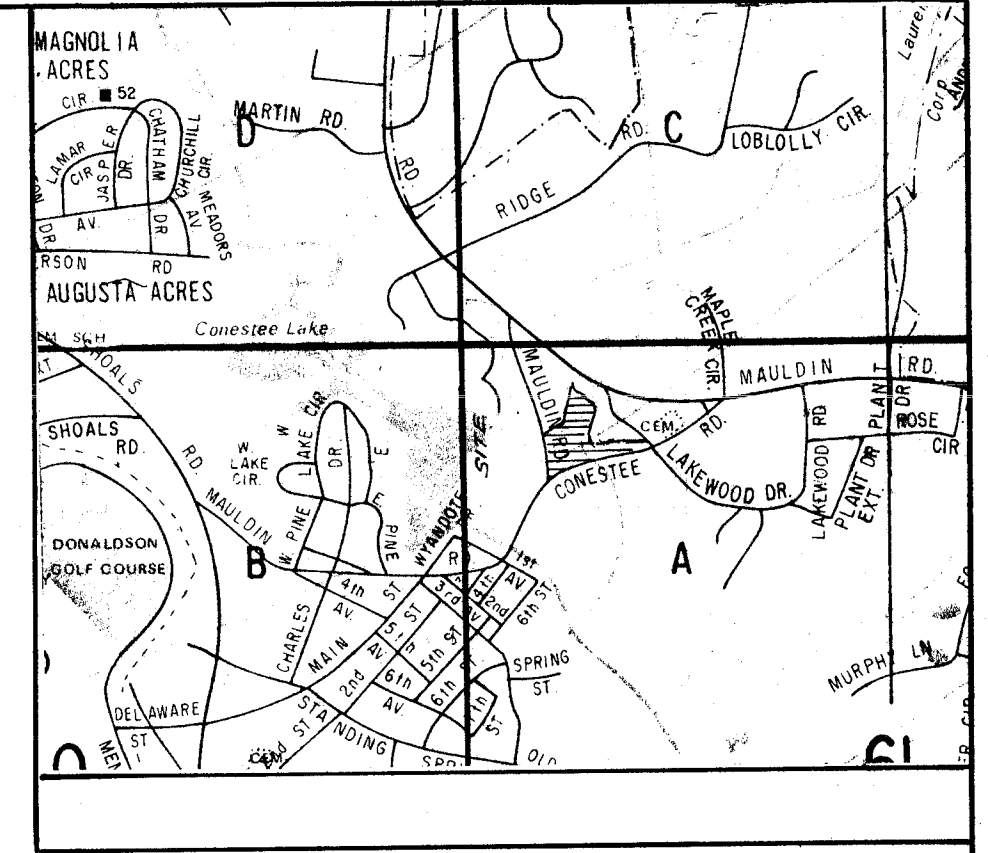


(PART 423-1-3.5)

(423-1-3)

10.19 ACRES TOTAL

(M 12.1-1-20)

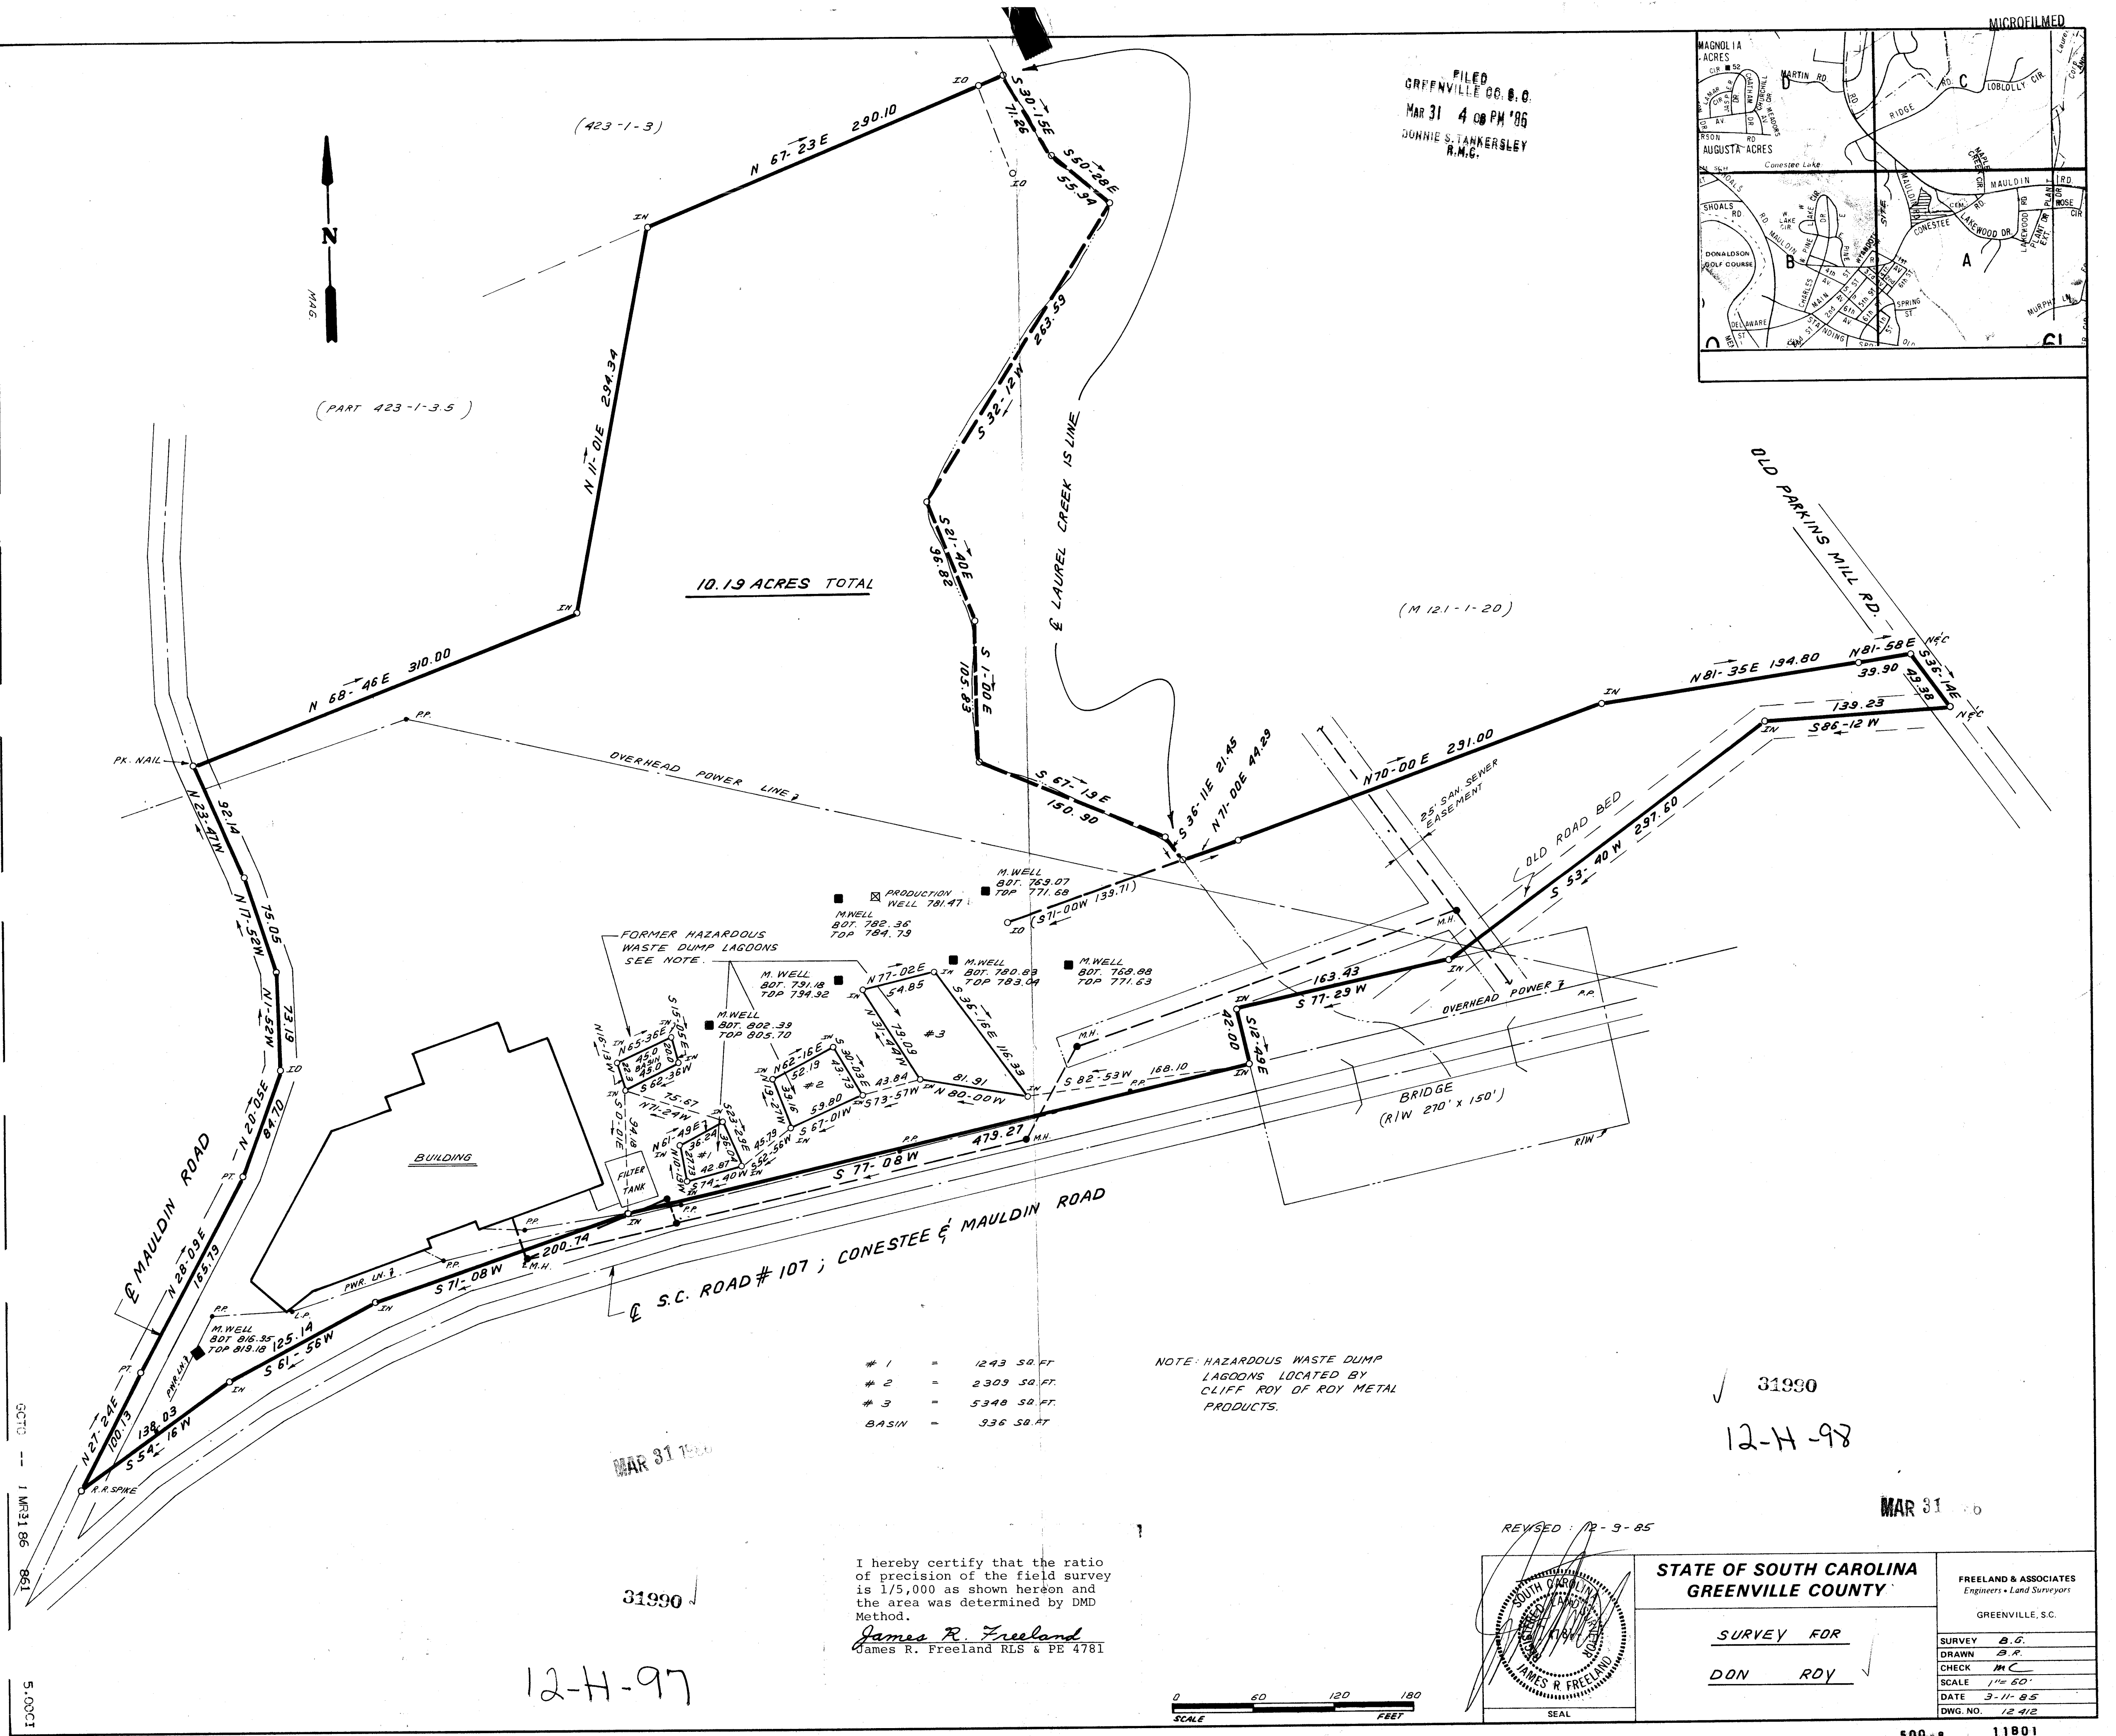

MAR 31 1986

- # 1 = 1243 SQ. FT.
- # 2 = 2309 SQ. FT.
- # 3 = 5348 SQ. FT.
- BASIN = 336 SQ. FT.

NOTE: HAZARDOUS WASTE DUMP LAGOONS LOCATED BY CLIFF ROY OF ROY METAL PRODUCTS.

I hereby certify that the ratio of precision of the field survey is 1/5,000 as shown hereon and the area was determined by DMD Method.

James R. Freeland
James R. Freeland RLS & PE 4781


12-H-97

31990

31990
12-H-98

MAR 31 1986

REVISED 12-9-85

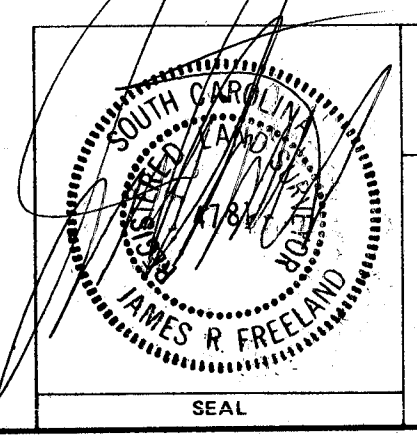

STATE OF SOUTH CAROLINA
GREENVILLE COUNTY

SURVEY FOR
DON RDY

FREELAND & ASSOCIATES Engineers - Land Surveyors GREENVILLE, S.C.	
SURVEY	B.G.
DRAWN	B.R.
CHECK	M.C.
SCALE	1" = 60'
DATE	3-11-85
DWG. NO.	12-112

