



MICROFILMED

Note: Improvements on this lot are not in a flood hazard area.

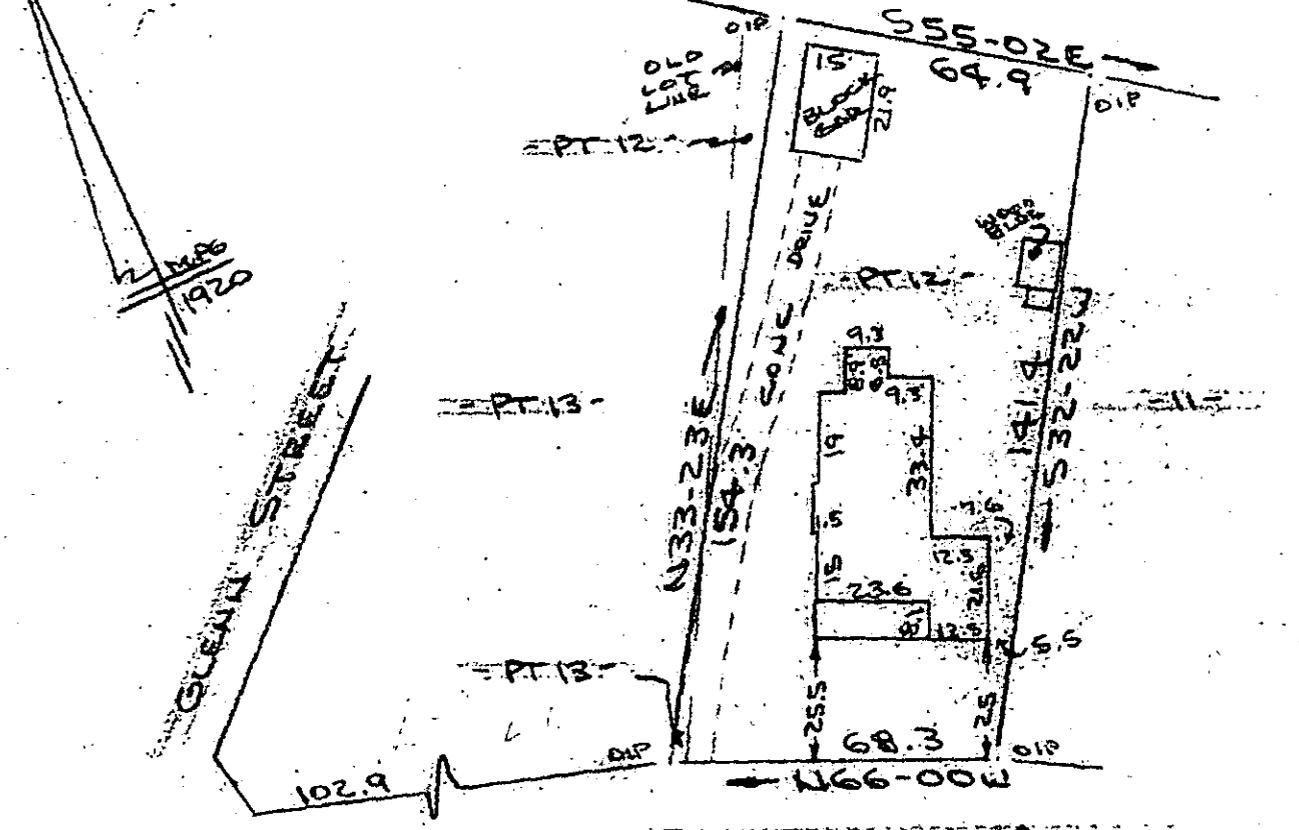

FILED
 GREENVILLE CO. S.C.
 JAN 16 9 57 AM '86
 DUNNIE S. JANKERSLEY
 R.M.C.

PROPERTY OF
 N. MICHAEL McBEE
 CITY OF GREENVILLE, S.C.
 SCALE: 1"=40' 14 JAN 1986

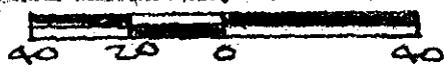

This is to certify that on the 14th day of January, 1986, I surveyed the property shown on this plat, being known as part of lot 12 and part of lot 13 on plat of MAP OF EAST OVER and recorded in the REC Office Greenville County, S. C., in Plat Book " F " at Page 42; and also known as PROPERTY OF N. MICHAEL McBEE and recorded in Plat Book at Page ; and that the property lines, walls and buildings are as shown hereon, and that the walls and buildings located on said lot do not encroach or project on adjacent street or property, and that no adjacent walls or buildings encroach or project on said premises, and no power lines cross this property except as shown hereon.

12-I-12

23676

R. B. Bruce

R. B. Bruce, RLS # 1952

JAN 16 1986

CAROLINA SURVEYING CO.
 112 Hanly St.
 Greenville, S. C.

JAN 16 1986

RECORDABLE PLAT
 JAN 16 1986