MICROFILMED
MAR 1986

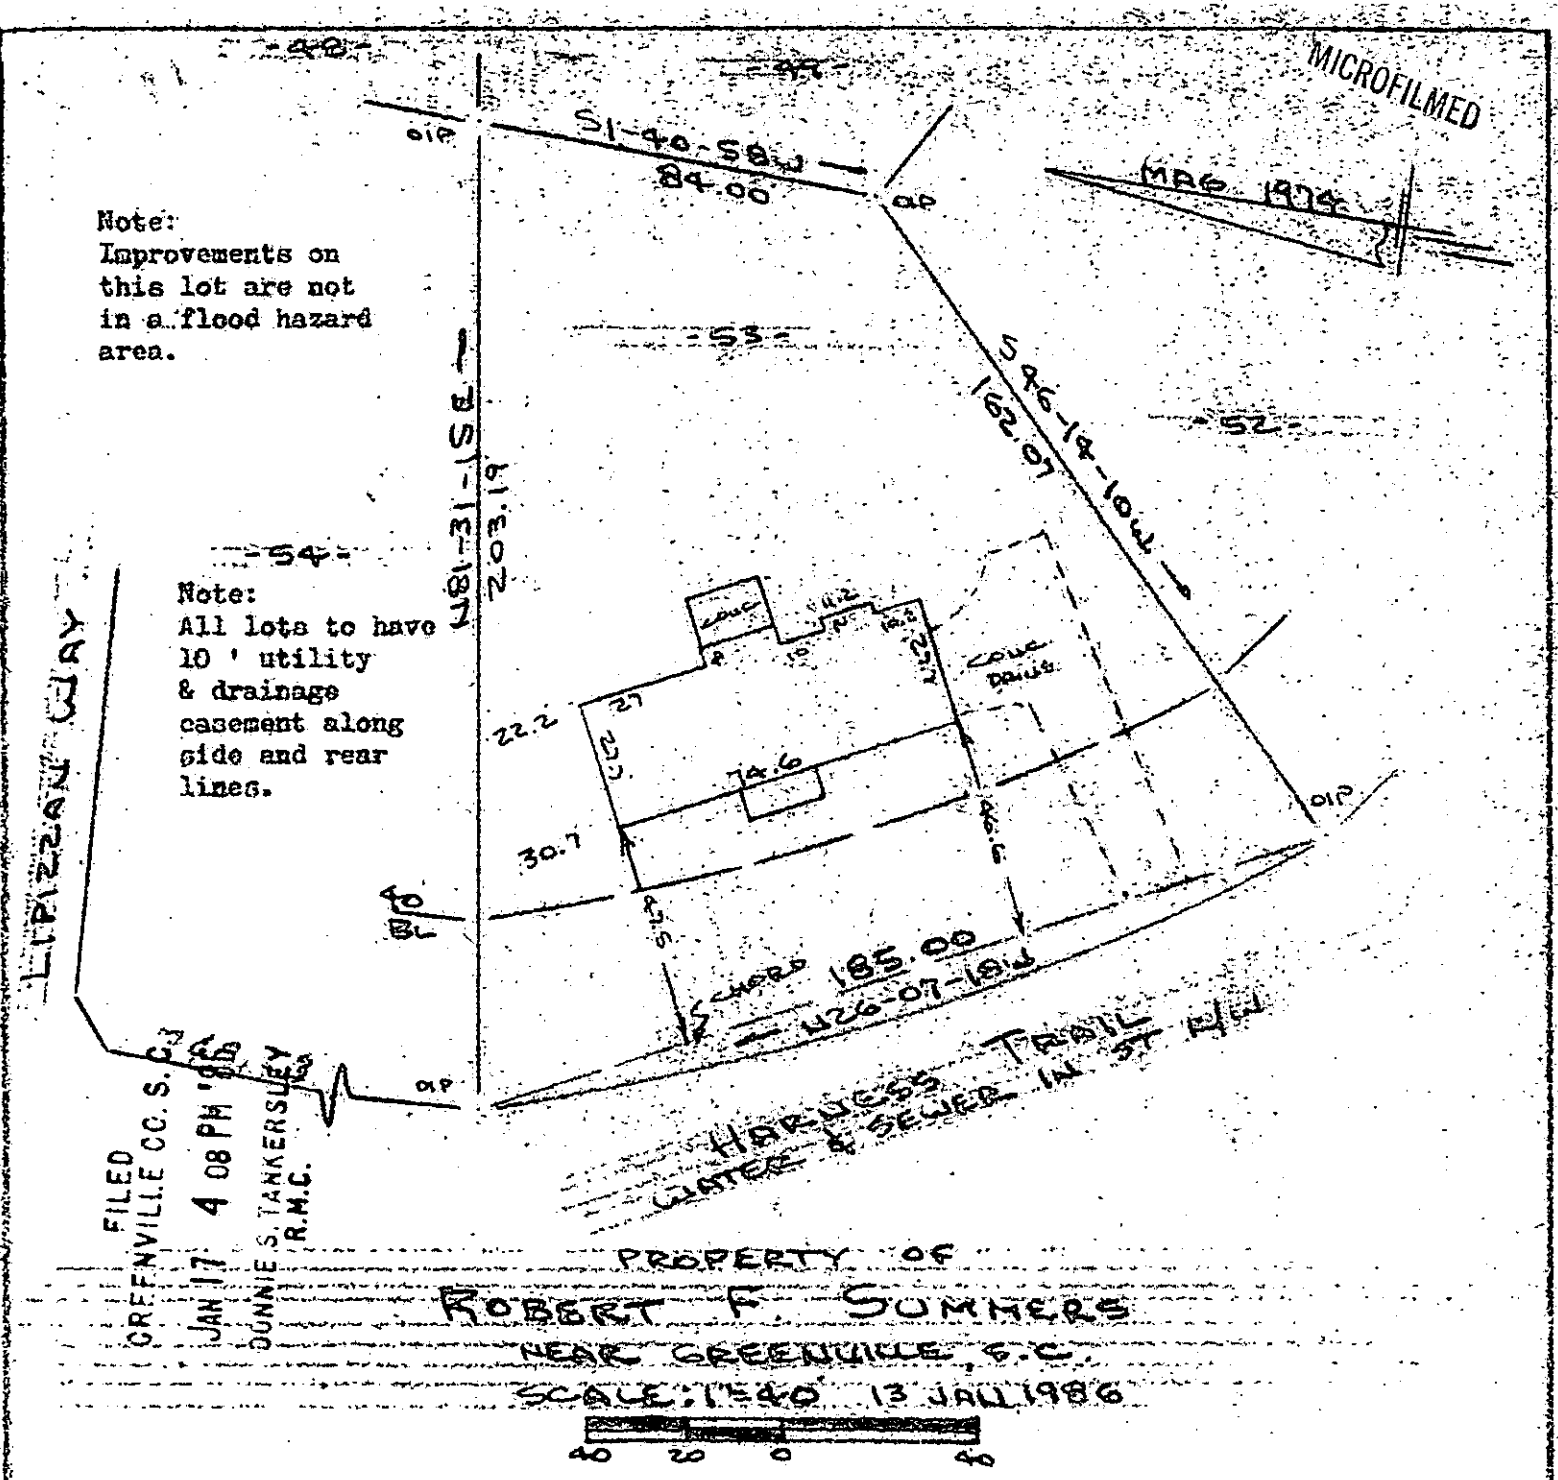

FILED
GREENVILLE CO. S.C.
JAN 17 4 08 PM '86
DONNIE S. TANKERSLEY
R.M.C.

This is to certify that on the 13th day of January, 1986, I surveyed the property shown on this plat, being known as lot 53 on plat of HERITAGE LAKES SUBDIVISION and recorded in the RMC Office Greenville County, S. C., in Plat Book " 6 - H " at Page 16; and that the property lines, walls and buildings are as shown hereon, and that the walls and buildings located on said lot do not encroach or project on adjacent street or property, and that no adjacent walls or buildings encroach or project on said premises, and no power lines cross this property except as shown hereon.

12-I 18 23830 R. B. Bruce

R. B. Bruce, RLS # 1952

CAROLINA SURVEYING CO.
112 Manly St.
Greenville, S. C.

3.00 8 31801

301/13 539.4-1-53