

HEATHWOOD DRIVE

CREIGHTON STREET

FILED
 GREENVILLE CO. S.C.
 JAN 24 A 52 PM '86
 DONNIE S. TANKERSLEY
 R.M.C.

JAN 24 1986

12I-42

This is to certify that on DEC. 9, 1985, I surveyed the property shown on this plat, known as Lot 173 on Plat of Colonial Hills, Sec. 4, recorded in the RMC Office of Greenville County in Plat Book WWV on Page 3, and that the property lines, walls, and buildings are as shown hereon; that the building located on said lot does not encroach or project on adjacent streets or property, and that no adjacent walls or buildings encroach or project on said premises, and that no utility lines cross this property except as shown hereon. This property is not located in a designated flood hazard area.

James R. Freeland
 James R. Freeland RLS & PE 4781

24558

**STATE OF SOUTH CAROLINA
 GREENVILLE COUNTY**

COLONIAL HILLS

SEC. 4 - LOT 173

PROPERTY OF

ALFONZO DANIEL

RUBY M. DANIEL MAR 24 86

FREELAND & ASSOCIATES
 Engineers • Land Surveyors

GREENVILLE, S.C.

SURVEY J.G.


DRAWN M.C.

CHECK M.H.C.

SCALE 1" = 30'

DATE 12-9-85

DWG. NO. 14258

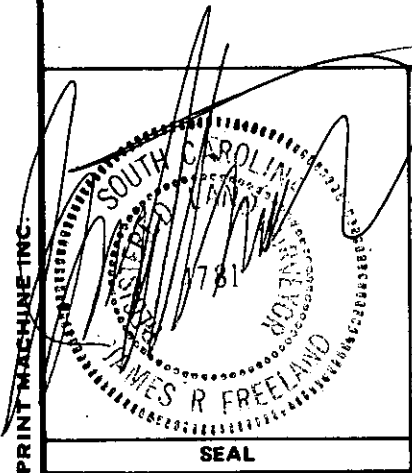

SEAL

(6486)