


GRUND

MORR STREET
WATER & SEWER DEPT C/W

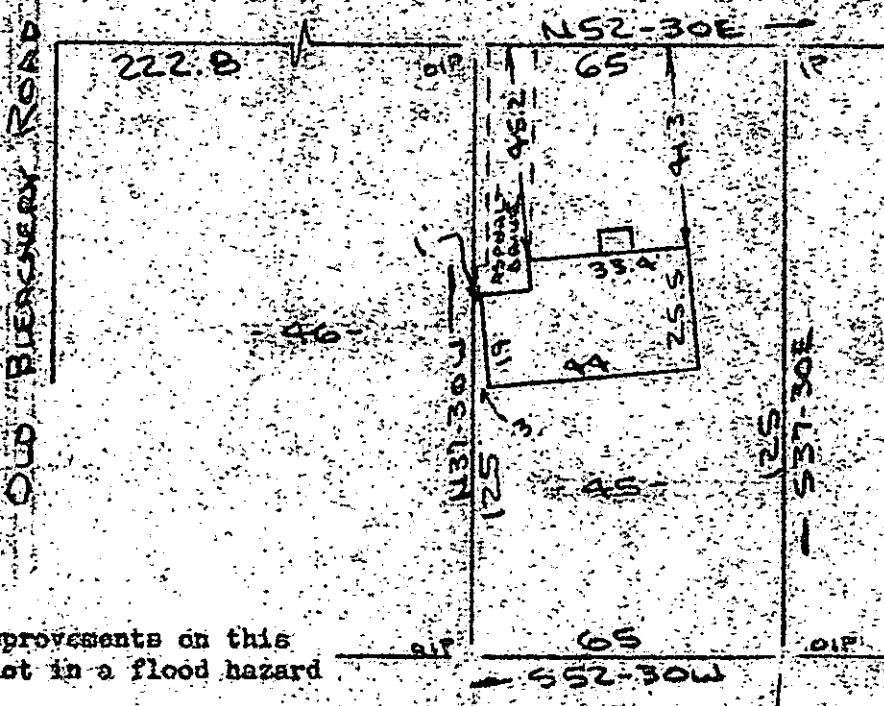

Note: Improvements on this lot are not in a flood hazard area.

WELLER SPRINGS MISSION TO

PROPERTY OF

CHRISTIE C. CASTELLAW

NEAR GREENHORN S.C.

SCALE: 1" = 40' 23 JAN 1986

40 30 0 40

This is to certify that on the 23rd day of January, 1986, I surveyed the property shown on this plat, being known as lot 45 on plat of PROPERTY OF LESLIE AND SHAW INC. and recorded in the RMC Office Greenville County, S. C., in Plot Book "NN" at Page 3; and that the property lines, walls and buildings are as shown herein, and that the walls and buildings located on said lot do not encroach or project on adjacent street or property, and that no adjacent walls or buildings encroach or project on said premises, and no power lines cross this property except as shown herein.

JAN 22 1982

R. B. BRADBURY

R. B. Bruce, RIG # 1952

12-5-53

CAROLINA SURVEYING CO. 112 Manly St. Greenville, S. C. Ref Recordable Plat