MICROFILMED

FILED
GREENVILLE CO. S.C.
JAN 28 4 08 PM '86
DONNIE S. TANKERSLEY
R.M.C.

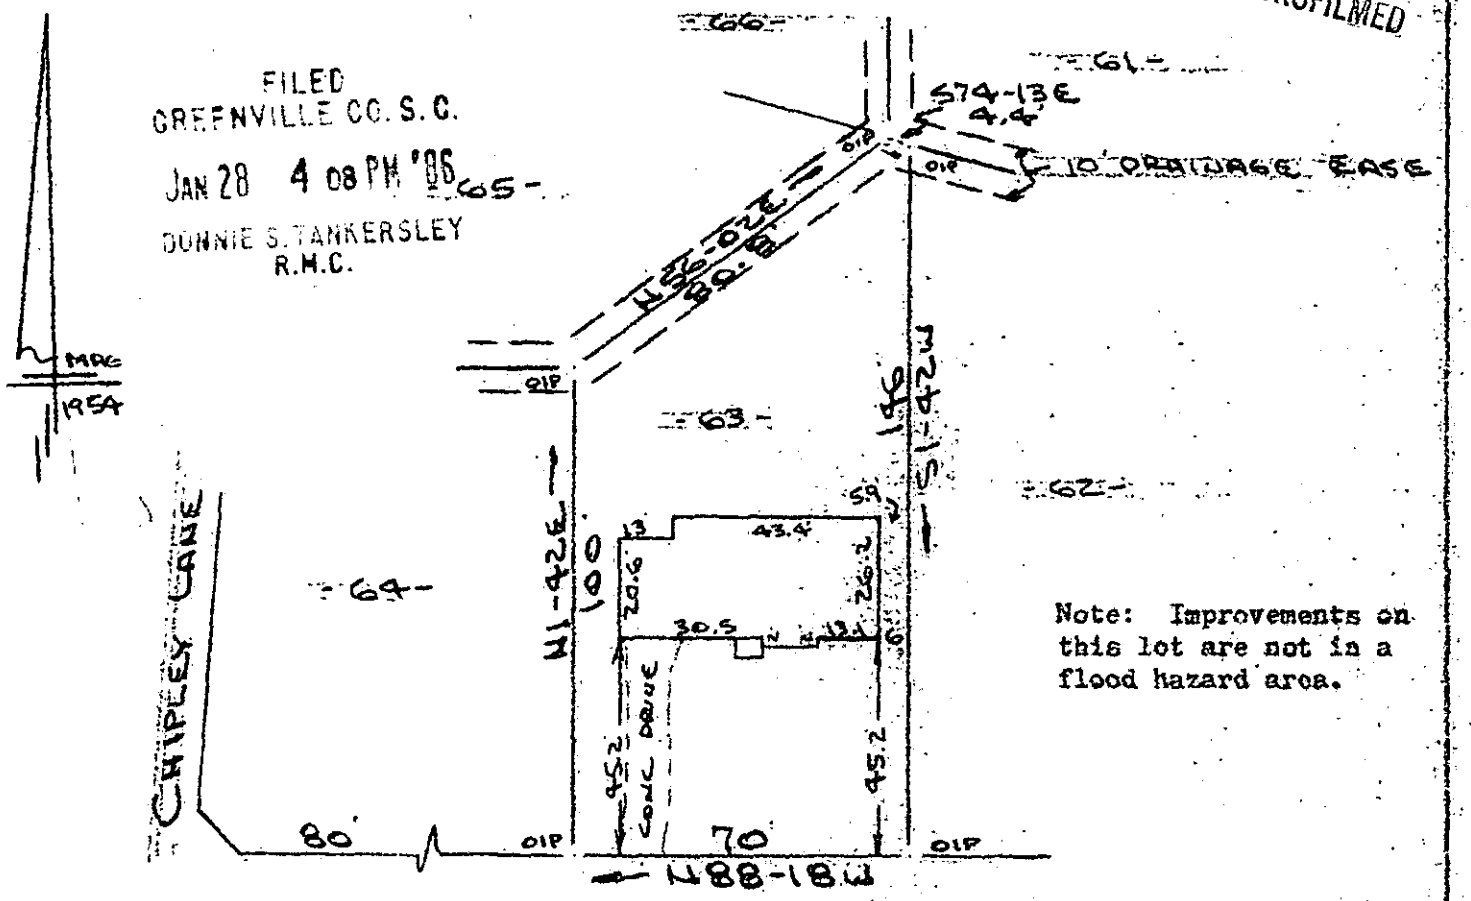

Note: Improvements on this lot are not in a flood hazard area.

SEQUOYA DRIVE
WATER & SEWER IN ST R/W

PROPERTY OF
MARK A. WILLIS & SHENIA T. WILLIS
NEAR GREENVILLE S.C.
SCALE 1"=40' 24 JAN 1986

40 20 0 40

This is to certify that on the 24th day of January, 1986, I surveyed the property shown on this plat, being known as lot 63 on plat of CHESTNUT HILLS and recorded in the RMC Office Greenville County, S. C., in Plat Book " GG " at Page 35 and also known as PROPERTY OF MARK A. WILLIS & SHENIA T. WILLIS and recorded in Plat Book at Page ; and that the property lines, walls and buildings are as shown hereon, and that the walls and buildings located on said lot do not encroach or project on said premises, and no power lines cross this property except as shown hereon.

JAN 28 1986

21880

12I-56

R. B. Bruce

R. B. Bruce, RLS # 1952

Recordable Plat

CAROLINA SURVEYING CO.
112 Manly St.
Greenville, S. C.

2 JA25 86

741

3.00CI

302/15

102-2-177