
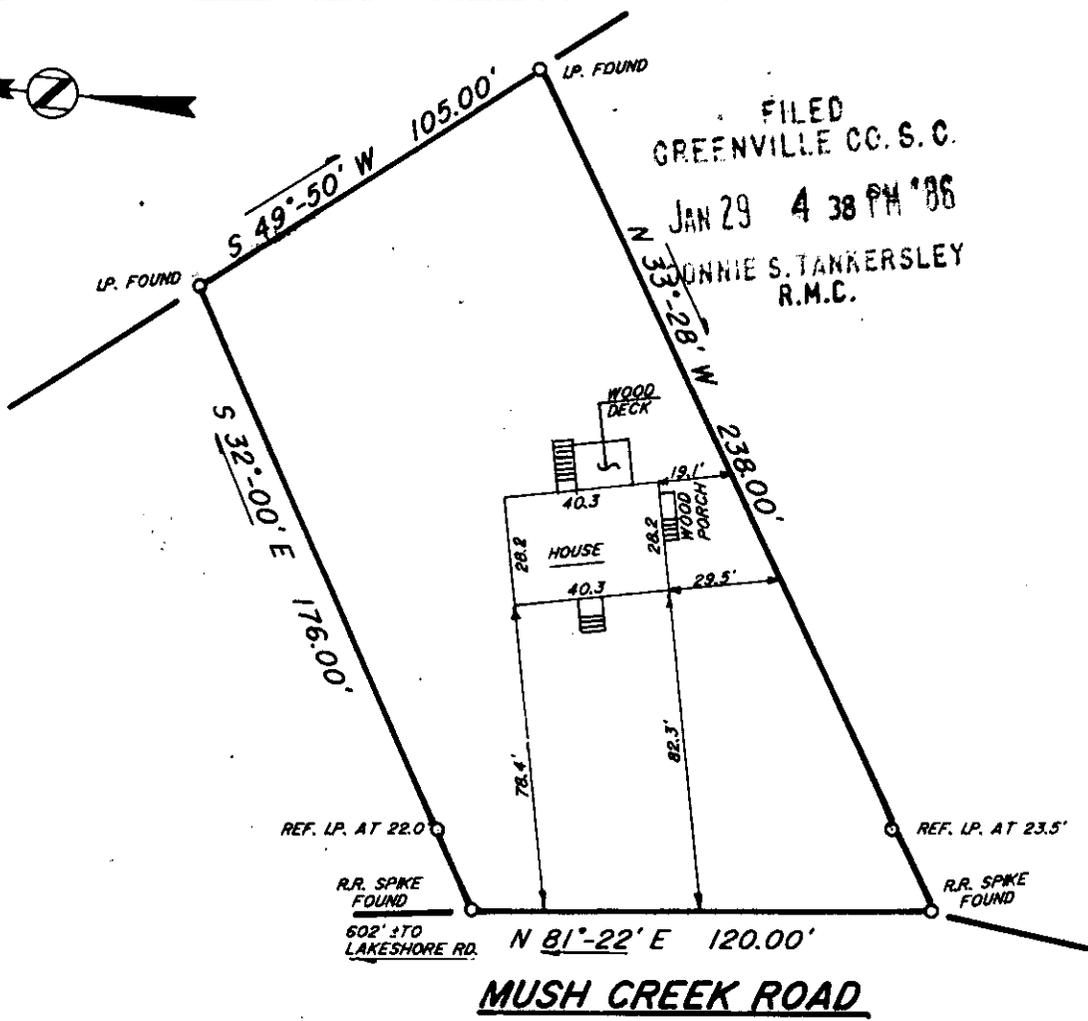


MICROFILMED

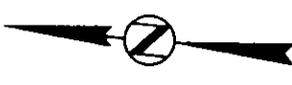

FILED
 GREENVILLE CO. S. C.
 JAN 29 4 38 PM '86
 JONNIE S. TANKERSLEY
 R.M.C.

This is to certify that on January 23, 1986, I surveyed the property shown on this plat, known as 0.50 Acres on plat of Property of Patricia B. Wilson and Margaret S. Biga, recorded in the R.M.C. Office of Greenville County in Plat Book _____ at Page _____, and in Plat Book 5M at Page 33, and that the property lines, walls and buildings are as shown hereon, that the building located on said lot does not encroach or project on adjacent streets or property, and that no adjacent walls or buildings encroach or project on said premises, and that no utility R/W's cross this property except as shown hereon. According to the Flood Rate Insurance Map and to the best of my knowledge, this structure is not in an Established Flood Zone.

JAN 29 1986

12I-60
25010



Frederick E. Landrith
 Frederick E. Landrith RLS 9545

THIS PROPERTY IS SUBJECT TO ANY AND ALL RIGHTS OF WAY AND EASEMENTS OF RECORD.

LANDRITH SURVEYING

Land Surveys - Topographical Maps
Construction Layout

628-C WADE HAMPTON BLVD.
 GREENVILLE, S.C. 29609
 (803) 271-8536

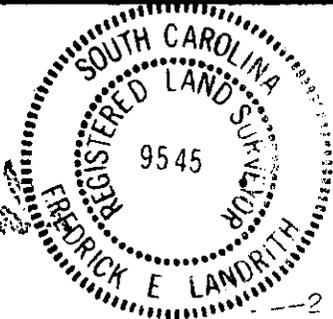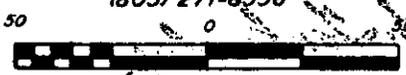

STATE of SOUTH CAROLINA COUNTY of GREENVILLE

PROPERTY OF

✓ **PATRICIA B. WILSON**
MARGARET S. BIGA 3.00CI

SURVEYED BY <i>JMW</i>	CHK'D BY <i>FEL</i>
DRAWN BY <i>JMW</i>	DATE <i>JAN 24, 1986</i>

SEAL

PROJECT NO. 86-546