


Note: Drainage & utilities easement 5' each side of side and rear lot lines.

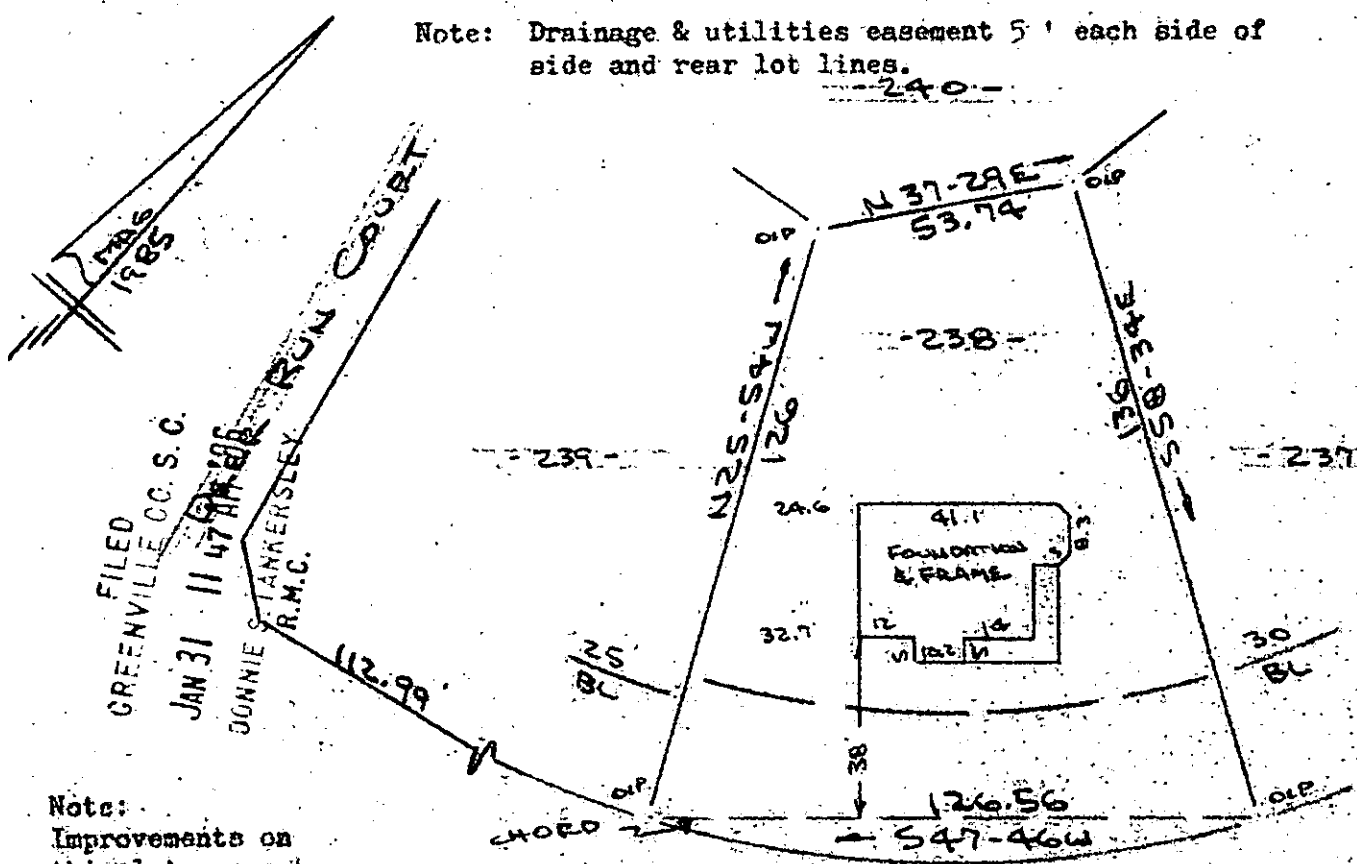

FILED  
 1985  
 GREENVILLE CO. S.C.  
 JAN 31 11 47 AM 1986  
 DONNIE S. TANKERSLEY  
 R.M.C.  
 RUN COURT

Note:  
 Improvements on  
 this lot are not  
 in a flood hazard  
 area.

FOX HOUND ROAD  
 WATER & SEWER IN ST. R/W

PROPERTY OF  
**GABRIEL BUILDERS INC.**  
 NEAR SIMPSONVILLE GREENVILLE CO. S.C.  
 SCALE: 1"=40' 29 JAN 1986



This is to certify that on the 29th day of January, 1986, I surveyed the property shown on this plat, being known as lot 238 on plat of SECTION ONE PHASE ONE HUNTERS WOODS and recorded in the RMC Office Greenville County, S. C., in Plat Book " 11 - I. " at Page 9; and that the property lines, walls and buildings are as shown hereon, and that the walls and buildings located on said lot do not encroach or project on adjacent street or property, and that no adjacent walls or buildings encroach or project on said premises, and no power lines cross this property except as shown hereon.

12-I-66 25347

JAN 31 1986

*R. B. Bruce*  
 R. B. Bruce, RLS # 1952

CAROLINA SURVEYING CO.  
 112 Manly St.  
 Greenville, S. C.

Recordable Plat  
 21801