


MICROFILMED

TYPICAL PLAN FOR THE FOLLOWING UNITS

9, 10, 11, 12
69, 70, 71, 72
72A, 72B, 72C, 72D

FILED
GREENVILLE CO. S. C.
JAN 23 4 12 PM '86
DONNIE S. TANKERSLEY
R.M.C.

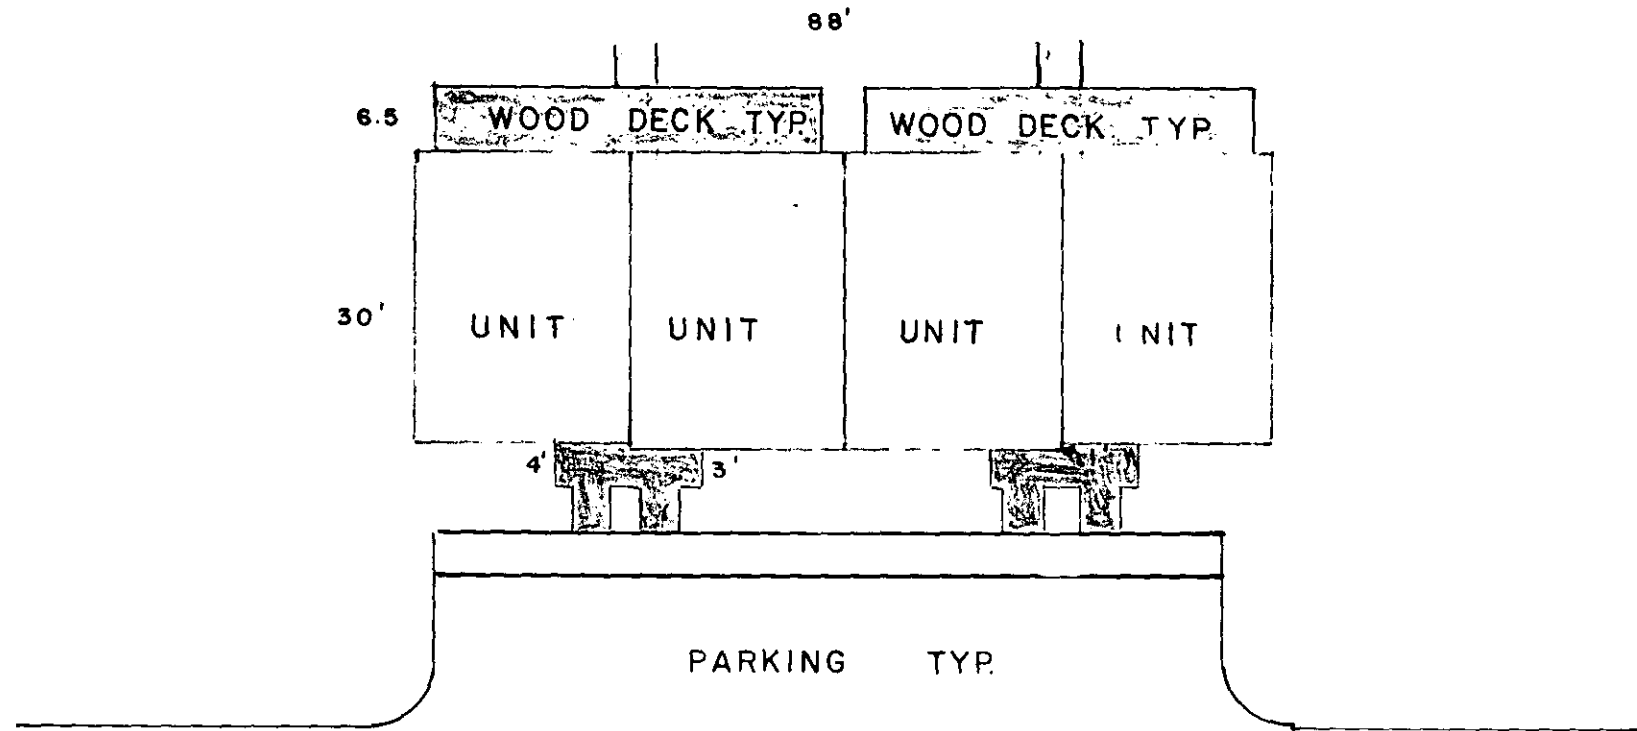

PAVED


ROAD

JAN 23 1986 24383

12-5-20

I HEREBY CERTIFY THE LIMITED COMMON ELEMENTS AS SURVEYED BY WEBB SURVEYING GROUP AND AS SHOWN ON THIS DRAWING.

SIGNED Donnie S. Tankersley DATE 12-23-85

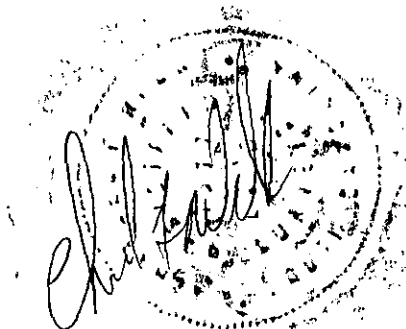

- I HEREBY CERTIFY THE RATIO OF PERECSON OF THE FIELD SURVEY IS 1/ _____ THE AREA WAS DETERMINED BY _____ CALCULATION
- I HEREBY CERTIFY THAT THE PROPERTY LINES AND ANY IMPROVMENTS ARE CORRECT AND NO VISIBLE ENCROACHMENTS EXIST UNLESS OTHERWISE SHOWN
- THIS PROPERTY IS SUBJECT TO ANY EASEMENTS OR RIGHT OFWAYS OF RECORD OR NOT OF RECORD
- THIS PLAT FOR REBORING IS NOT WITHIN A FLOOD HAZARD AREA

THIS PLAT IS NOT A SUBDIVISION AS DEFINED BY THE GREENVILLE COUNTY SUDIVISION REGULATIONS.

1-25-1986 John H. Olding
Chairman, Secretary, or Director of Planning.
Greenville County Planning Commission

NOTE [Symbol] = LIMITED COMMON ELEMENTS

SURVEY FOR
WILLIAMSBURG AT BOTANY WOODS
HORIZONTAL PROPERTY REGIME.
GREENVILLE CO. SOUTH CAROLINA

WEBB SURVEYING & MAPPING GROUP
P.O. BOX 4756 - 29608

20 0 20 40

SCALE 1" = 20 FT.
DATE DEC. 23 1985

THE PRINT MACHINE, INC. No. 6301