


MICROFILMED

TYPICAL PLAN FOR THE FOLLOWING UNITS

- 41, 42, 43, 44
- 45, 46, 47, 48
- 81, 82, 83, 84
- 97, 98, 99, 100

FILED
 GREENVILLE CO. S. C.
 JAN 23 4 12 PM '86
 DONNIE S. TANKERSLEY
 R.M.C.

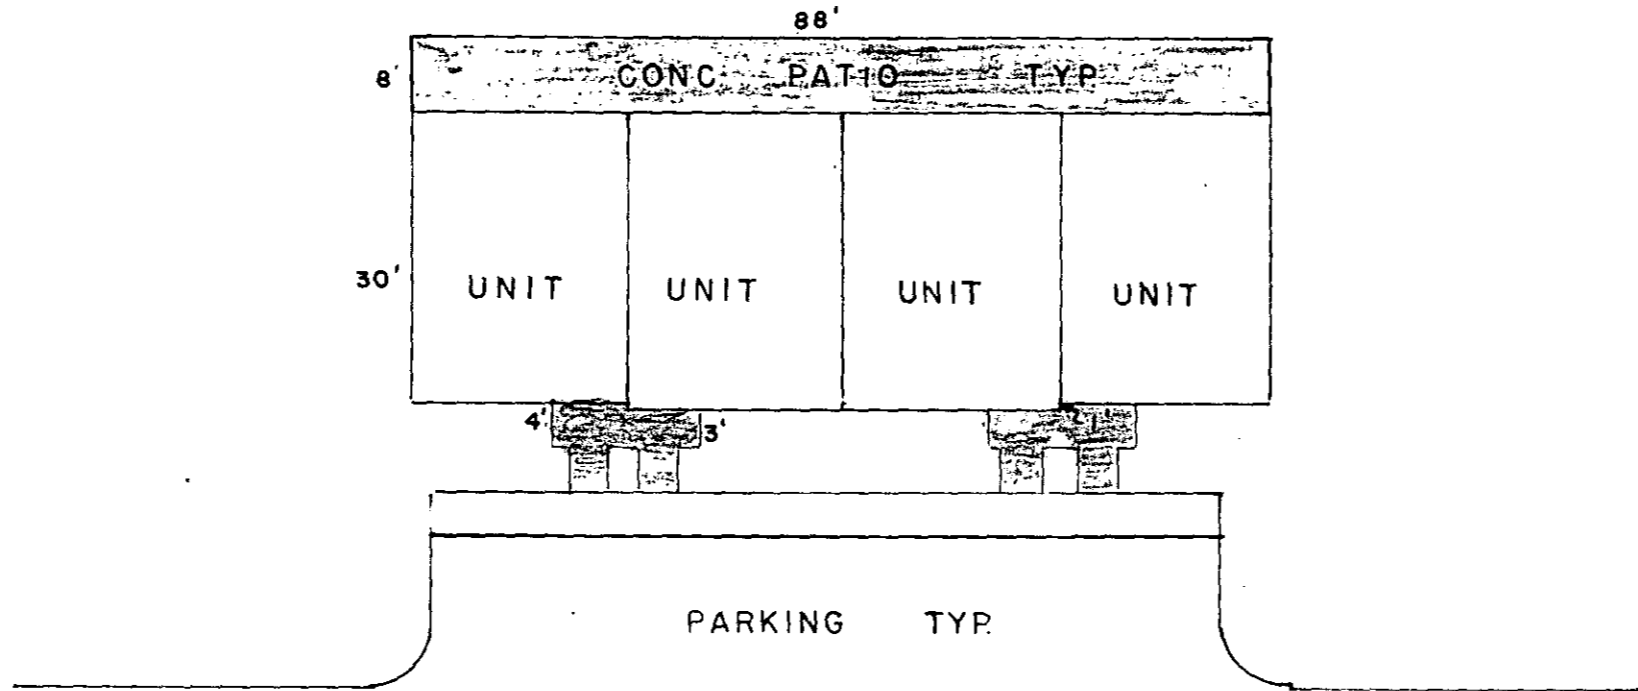

PAVED

ROAD

24383

JAN 23 1986

12-J-23


I HEREBY CERTIFY THE LIMITED COMMON ELEMENTS AS SURVEYED BY WEBB SURVEYING GROUP AND AS SHOWN ON THIS DRAWING.

SIGNED *Ronald O. Day* DATE 12-23-85

THIS PLAT IS NOT A SUBDIVISION
 AS DEFINED BY THE GREENVILLE
 COUNTY SUBDIVISION REGULATIONS.
 1-23-1986 *John H. Williams Jr.*
 Chairman, Secretary, or Director of
 Planning.
 Greenville County Planning Commission

SURVEY FOR
 WILLIAMSBURG AT BOTANY WOODS
 HORIZONTAL PROPERTY REGIME
 GREENVILLE CO. SOUTH CAROLINA

WEBB SURVEYING & MAPPING GROUP
 P.O. BOX 4756 - 29608

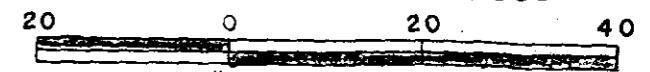

SCALE 1" = 20 FT.
 DATE DEC. 23 1985

- I HEREBY CERTIFY THE RATIO OF PERECSON OF THE FIELD SURVEY IS 1/_____ THE AREA WAS DETERMINED BY _____ CALCULATION
- I HEREBY CERTIFY THAT THE PROPERTY LINES AND ANY IMPROVMENTS ARE CORRECT AND NO VISIBLE ENCROACHMENTS EXIST UNLESS OTHERWISE SHOWN
- THIS PROPERTY IS SUBJECT TO ANY EASEMENTS OR RIGHT OF WAYS OF RECORD OR NOT OF RECORD
- THIS IS NOT WITHIN A FLOOD HAZARD AREA

NOTE [Symbol] = LIMITED COMMON ELEMENTS

THIS PLAT FOR RECORD

THE PRINT MACHINE, INC. N66301