


MICROFILMED

TYPICAL PLAN FOR THE FOLLOWING UNITS

49, 50, 51, 52
61, 62, 63, 64

FILED
GREENVILLE CO. S. C.
JAN 23 4 12 PM '86
DONNIE S. TANKERSLEY
R.M.C.

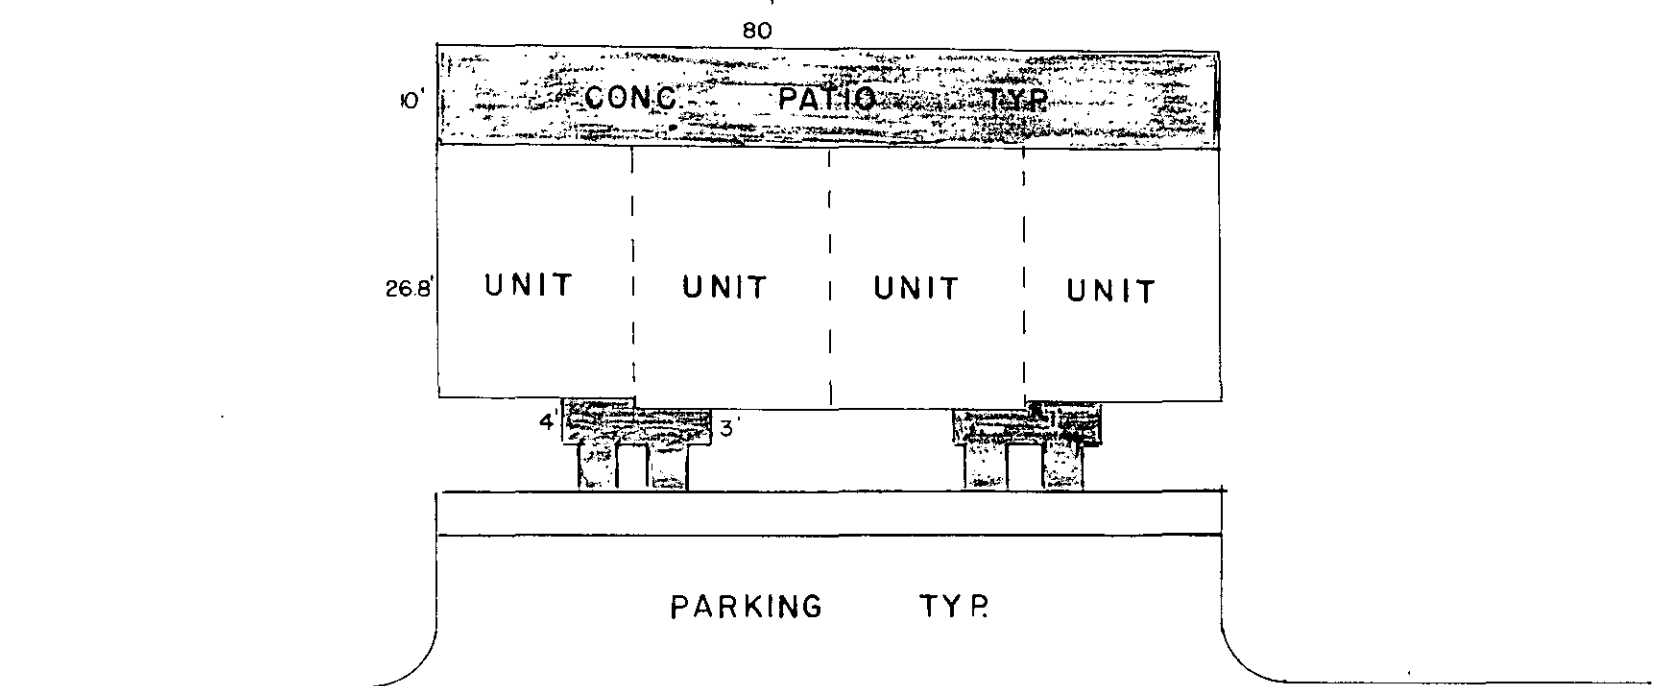

PAVED

ROAD

JAN 23 1986

12-J-24
24383

I HEREBY CERTIFY THE LIMITED COMMON ELEMENTS AS SURVEYED BY WEBB SURVEYING GROUP AND AS SHOWN ON THIS DRAWING.

SIGNED Donnie S. Tankersley DATE 12-23-85

THIS PLAT IS NOT A SUBDIVISION
AS DEFINED BY THE GREENVILLE
COUNTY SUBDIVISION REGULATIONS.
1/23/1986 John H. Oving Jr.
Chairman, Secretary, or Director of
Planning.
Greenville County Planning Commission

SURVEY FOR
WILLIAMSBURG AT BOTANY WOODS
HORIZONTAL PROPERTY REGIME
GREENVILLE CO. SOUTH CAROLINA

WEBB SURVEYING & MAPPING GROUP
P.O. BOX 4756 - 29608



SCALE 1" = 20 FT.
DATE DEC. 23 1985

- I HEREBY CERTIFY THE RATIO OF PERECSON OF THE FIELD SURVEY IS 1/_____ THE AREA WAS DETERMINED BY _____ CALCULATION
- I HEREBY CERTIFY THAT THE PROPERTY LINES AND ANY IMPROYMENTS ARE CORRECT AND NO VISIBLE ENCROACHMENTS EXIST UNLESS OTHERWISE SHOWN
- THIS PROPERTY IS SUBJECT TO ANY EASEMENTS OR RIGHT OFWAYS OF RECORD OR NOT OF RECORD
- THIS _____ IS NOT WITHIN A FLOOD HAZARD AREA

NOTE [Symbol] = LIMITED COMMON ELEMENTS

THIS PLAT FOR RECORD

THE PRINT MACHINE, INC. N66301