MICROFILMED

REF: DEED BK 867 @ P. 277
PLAT BK 46 @ P. 25
" " 45 @ P. 27
ALSO PLAT BK 9M @ P. 41

FILED
GREENVILLE CO. S.C.
GREENVILLE CO. RMC OFFICE
JAN 29 10 18 AM '86
DONNIE S. TANKERSLEY
R.M.C.

MAG
1963

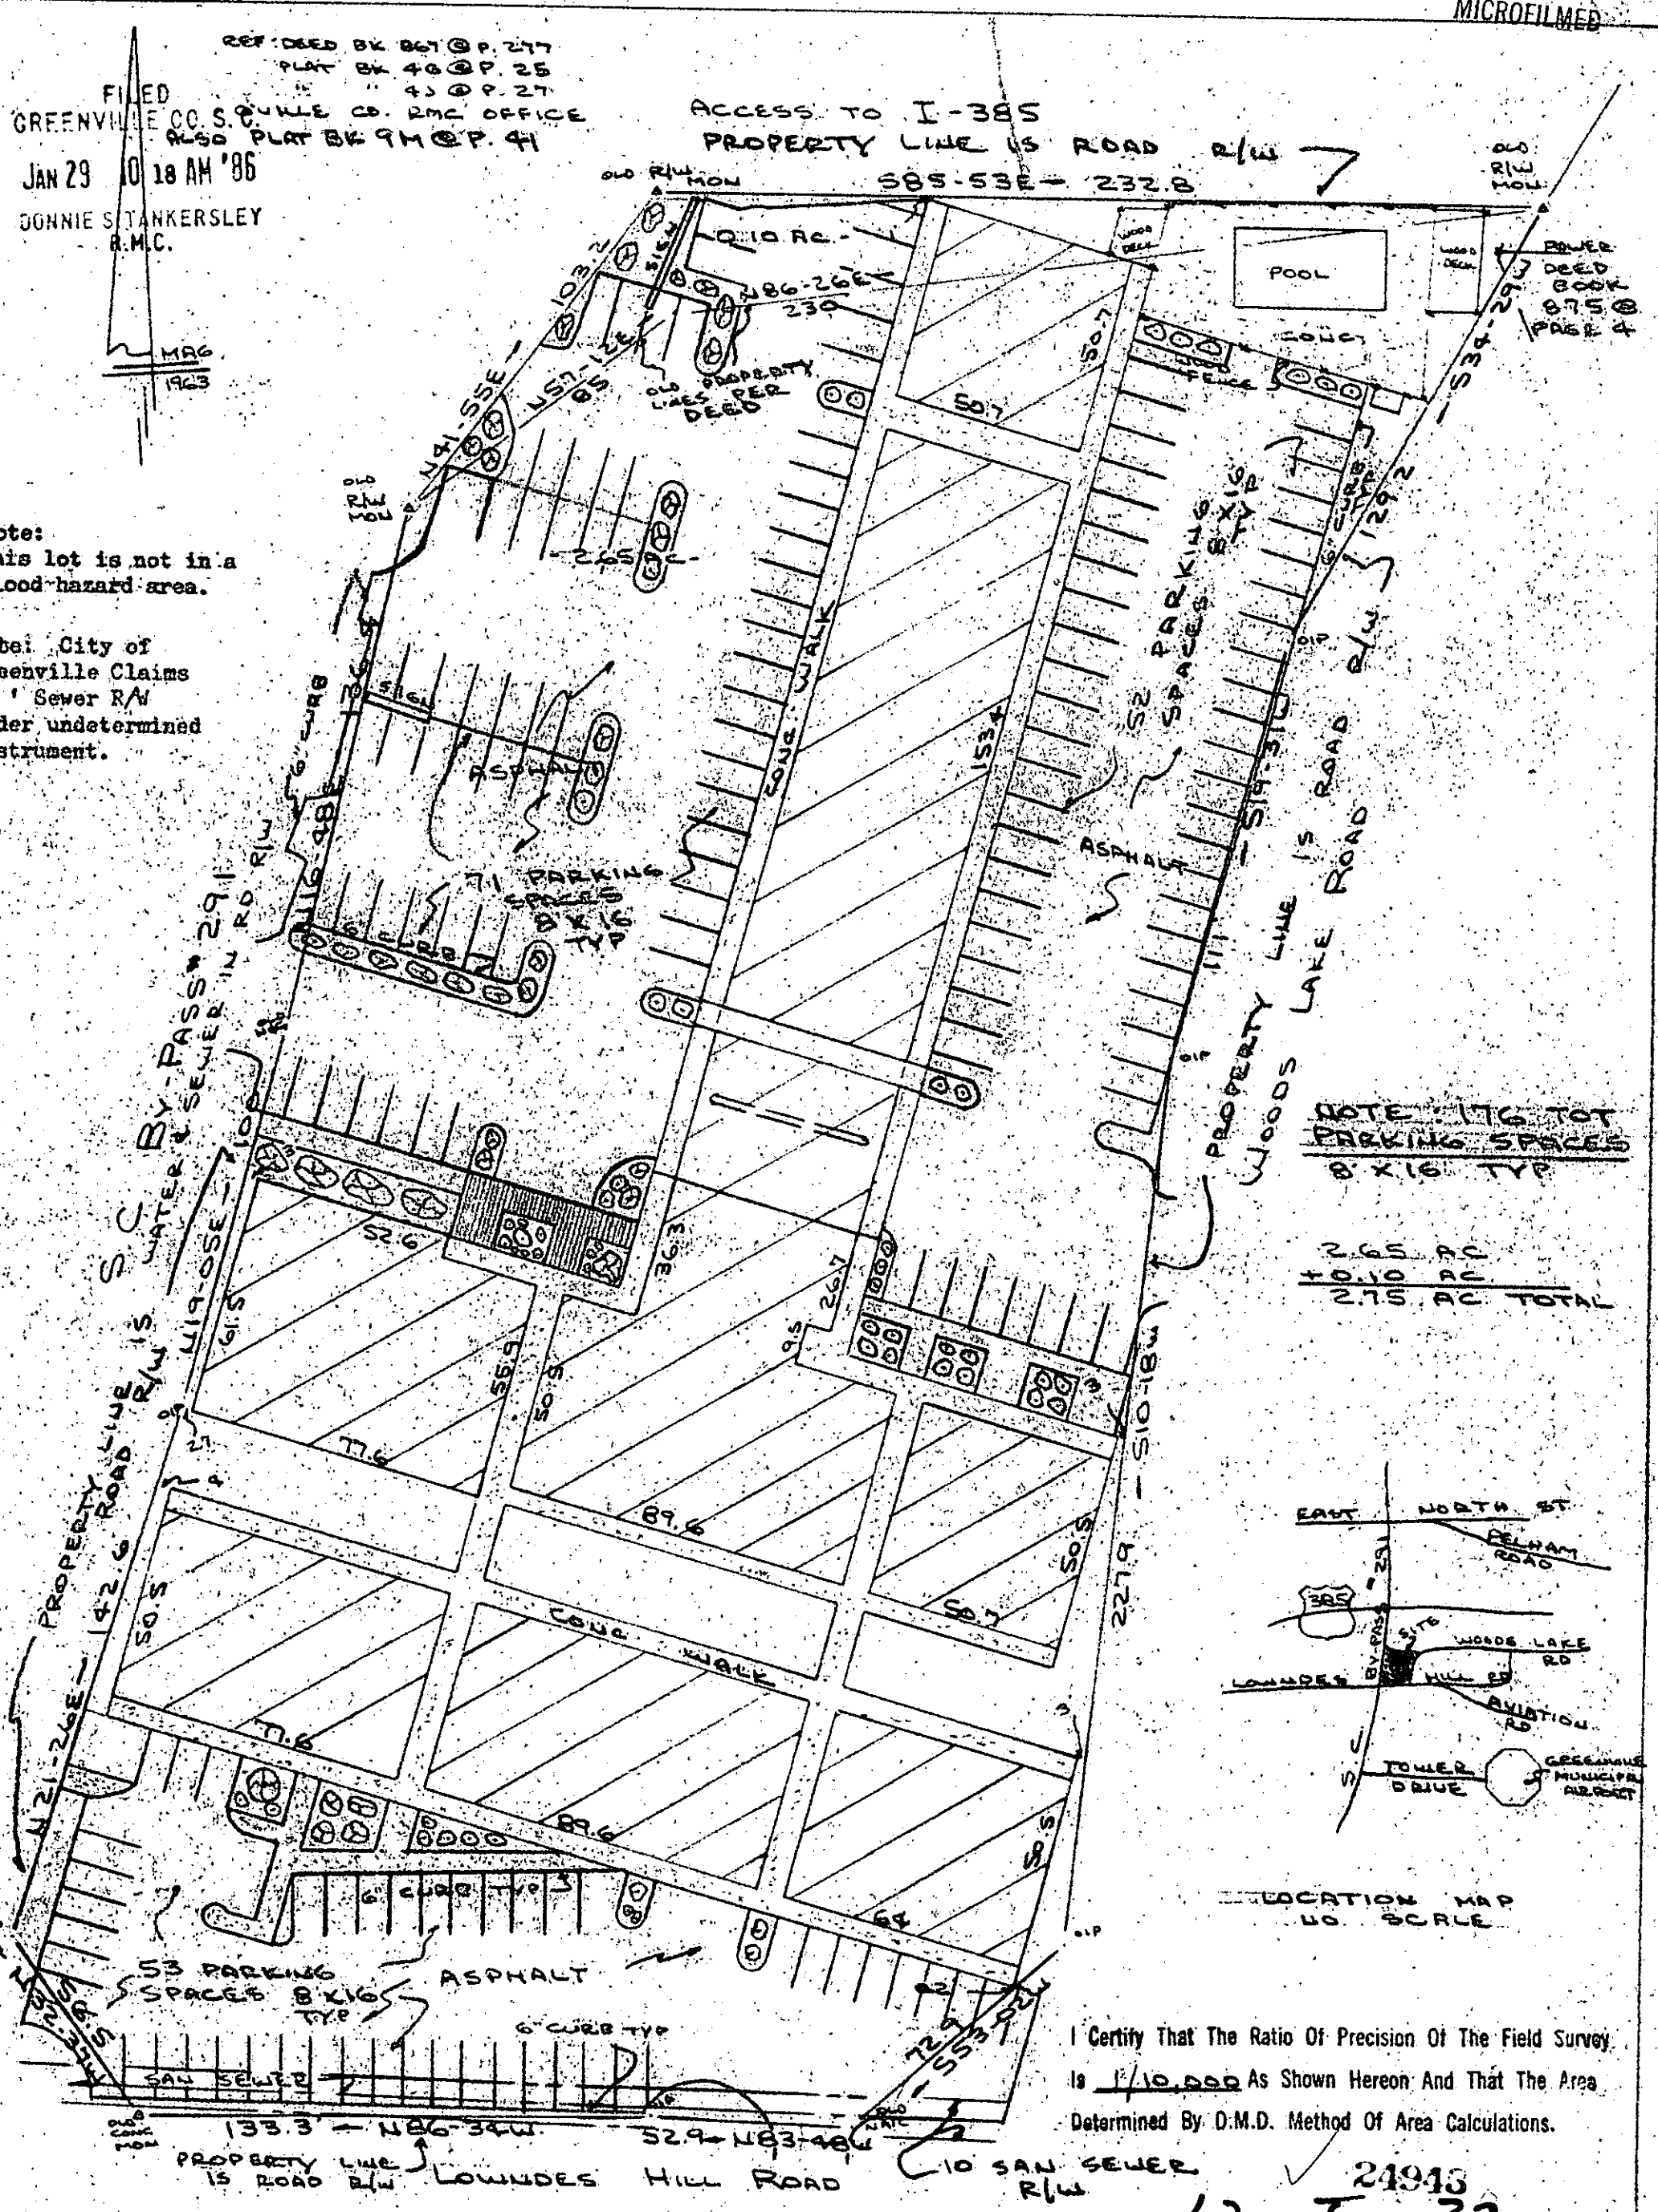

Note:
This lot is not in a flood hazard area.

Note: City of Greenville Claims 10 ' Sewer R/W under undetermined instrument.

NOTE: 176 TOT PARKING SPACES 8 X 16 TYP

2.65 AC
+0.10 AC
2.75 AC TOTAL

LOCATION MAP
NO SCALE

I Certify That The Ratio Of Precision Of The Field Survey Is 1/10,000 As Shown Hereon And That The Area Determined By D.M.D. Method Of Area Calculations.

24943

12-5-32

AS-BUILT SURVEY FOR
WOODLAWN ASSOCIATES A NORTH CAROLINA LIMITED PARTNERSHIP
GREENVILLE COUNTY, GREENVILLE, S.C.
SCALE: 1"=40' 12 DEC 1985 REV 27 JAN 1986

JAN 29 1986

TO: Lawyer's Title Insurance Corporation, Woodlawn Associates, a North Carolina Limited Partnership, and Life Insurance Company of Georgia:

This is to certify that on the 12th day of December, 1985, I surveyed the property shown on this plat and that this is a true and correct plat of survey; that the property lines, walls and buildings are as shown hereon, and that the walls and buildings located on said property do not encroach or project on adjacent streets or property, and that no adjacent walls or buildings encroach or project on this property; and that there are no rights of way or easements encroaching on the property except as shown hereon.

January 27, 1986

R. B. Bruce
R. B. Bruce, R. L. S. #1952

CAROLINA SURVEYING CO
112 MANLY ST
GREENVILLE, S.C.

JA 29 86 022

282-1-6

Recordable Plat

7281