


REFERENCE :


DEED BOOK 1109 - 452
PLAT BOOK XXX - 119A
BLOCK BOOK 23-1-21

FILED
GREENVILLE CO., S.C.
MAR 3 1 25 PM '86
DONNIE S. TANKERSLEY
P.E.C.
NORTH

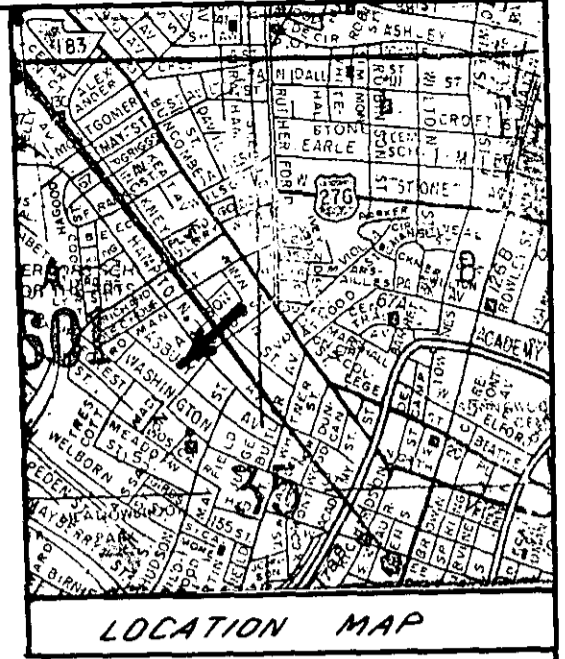

— S.C.H.D. —

— ANNIE B. BARKSDALE —

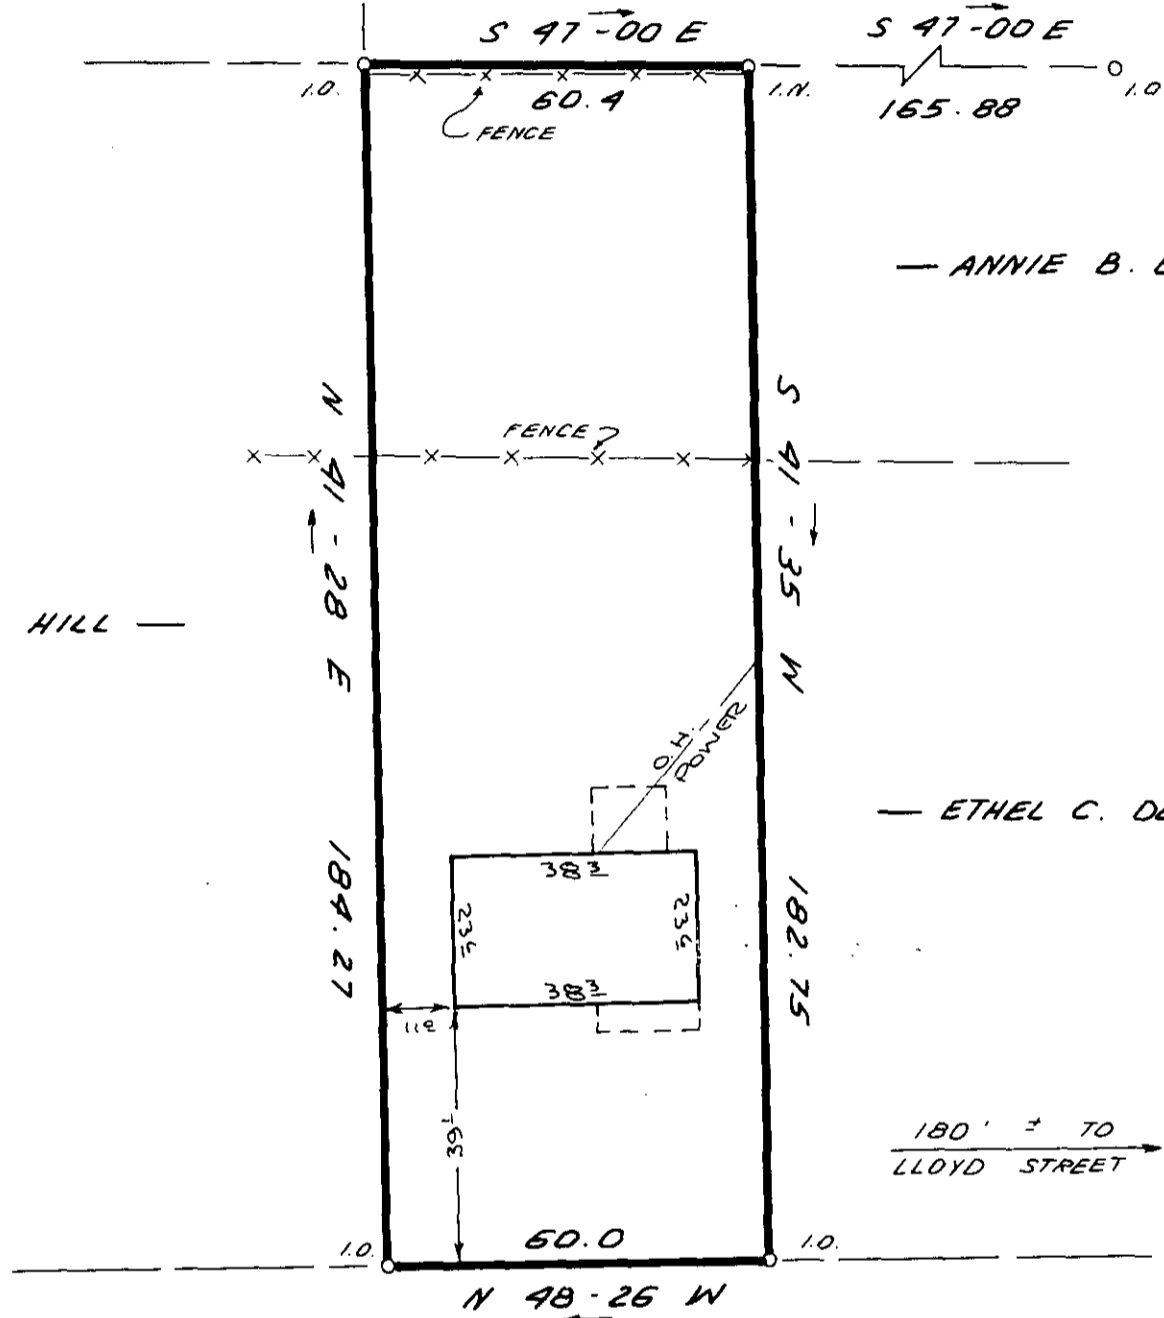

— ANNIE B. BARKSDALE —

— DELLA HILL —

— ETHEL C. DEMMONDS —

ASBURY AVENUE

MAR 3 1986

12-5-85


SURVEY FOR
CITY OF GREENVILLE
GREENVILLE SOUTH CAROLINA

28637

NOV. 18, 1985

REVISED 2-26-86
HOUSE LOCATION

SCALE: 1" = 30'

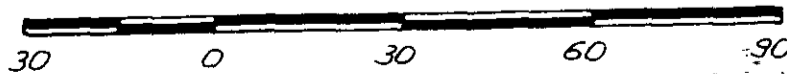

W. R. WILLIAMS, JR.
ENGR./SURVEYOR, Inc.
P. E. & L. S. No. 3979
15 S. MAIN STREET
TRAVELERS REST, S. C.
29690

"I hereby certify that the ratio of precision of the field survey is 1/10000 as shown hereon and the area was determined by U.M.D. method of area calculation."

W. R. Williams, Jr.

P. E. & L. S. No. 3979

F.B. # 83

GCTD

MAR 3 1986

5.0000