



FILED  
GREENVILLE CO., S.C.

FEB 10 3 13 PM '86

DONNIE S. TANKERSLEY  
R.M.C.




APRICOT LANE

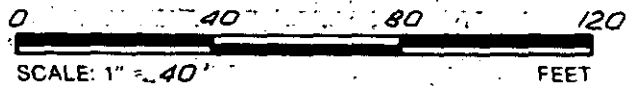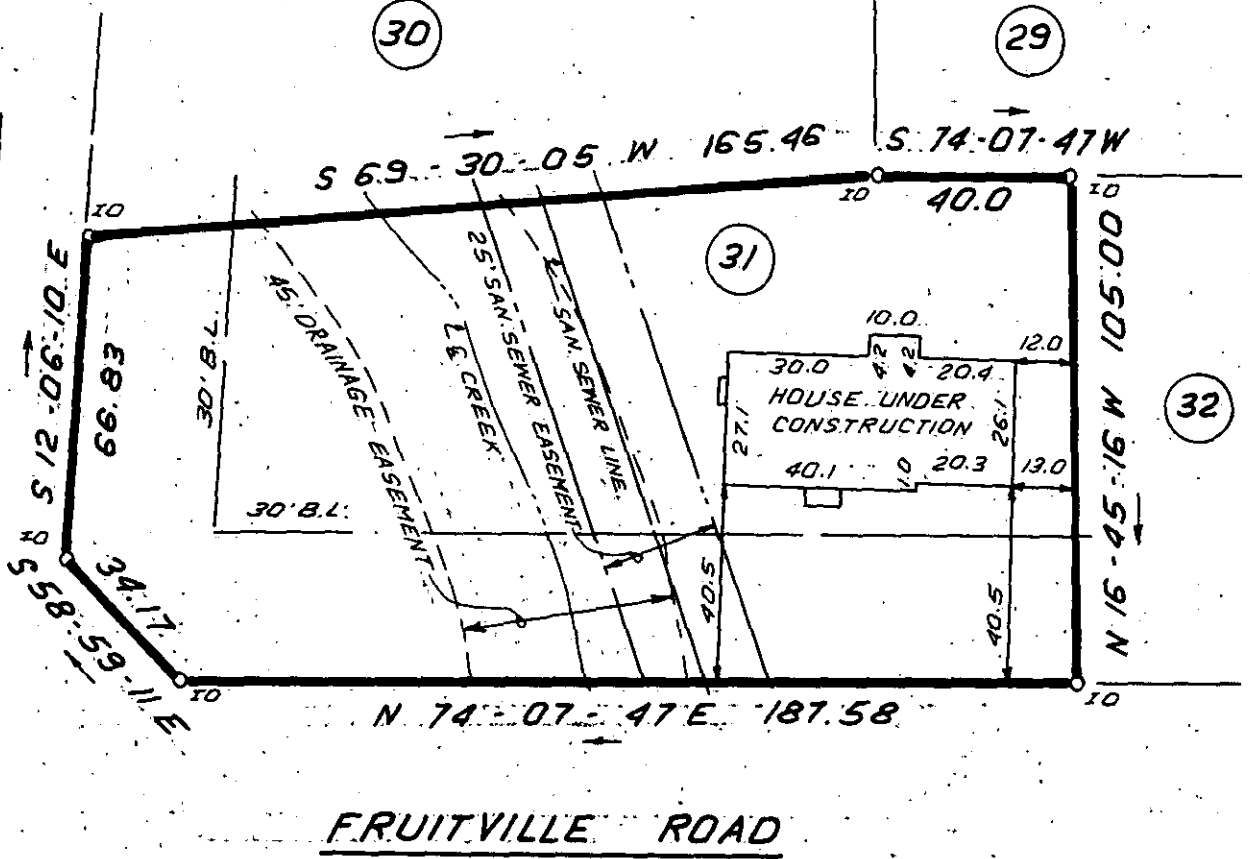

NOTE: 5' DRAINAGE & UTILITY EASEMENT ALONG EACH SIDE OF ALL SIDE LOT LINES & 10' EACH SIDE OF ALL REAR LOT LINES.

THIS IS TO CERTIFY THAT THE PROPERTY SHOWN ON THIS PLAT WAS SURVEYED UNDER MY DIRECT SUPERVISION. PROPERTY LINES AND IMPROVEMENTS SHOWN ARE LOCATED CORRECTLY AND THAT NO VISIBLE ENCROACHMENTS EXIST UNLESS OTHERWISE SHOWN. THIS PROPERTY IS NOT LOCATED IN A DESIGNATED FLOOD HAZARD AREA.

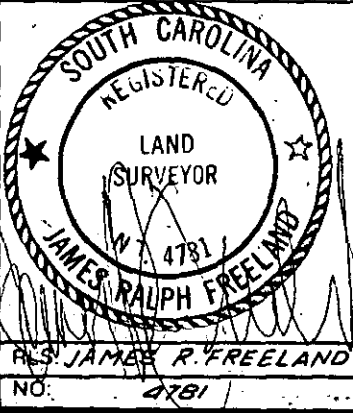

STATE OF SOUTH CAROLINA  
GREENVILLE COUNTY

CHANDLER RIDGE  
LOT 31 26353  
PROPERTY OF  
SAN-DEL BUILDERS INC.

12-K-19

FREELAND & ASSOCIATES  
Engineers • Land Surveyors  
318 WEST STONE AVENUE  
GREENVILLE, S.C.  
(803) 271-4924

PLAT BOOK 11-I-24

DEED BOOK

TAX MAP

PARTY CHIEF B.G.

DRAWN I.R.

DATE FEB. 5. 86

DWG. NO. 14594

2 FEB 10 26 221 3.00CT