MICROFILMED

MAP

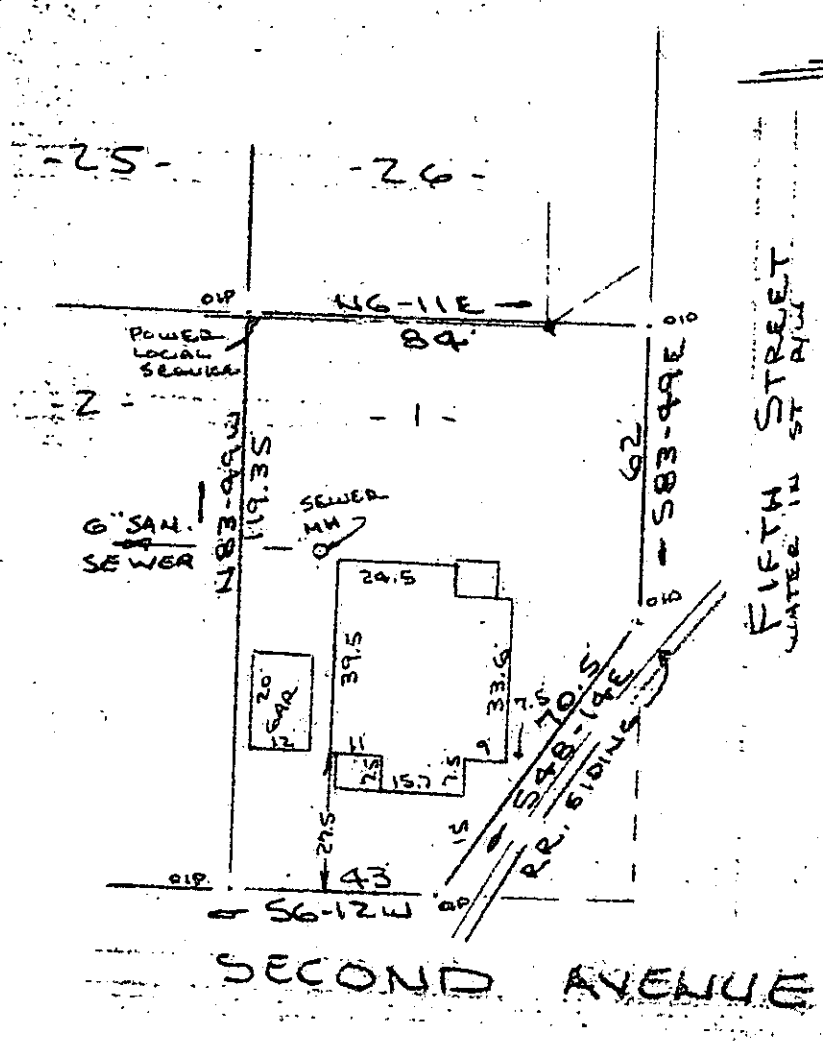

Note: Improvements on this lot are not in a flood hazard are.

FILED
GREENVILLE CO., S.C.
FEB 13 4 04 PM '86
DONNIE S. TANKERSLEY
R.M.C.

PROPERTY OF
TIMOTHY M. REID
NEAR GREENVILLE S.C.
SCALE: 1" = 40' 13 FEB 1986

40 20 0 40 80

This is to certify that on the 13th day of February, 1986, I surveyed the property shown on this plat, being known as lot 1 on plat of MAP OF SECTION NO. 3 JUDSON HILLS VILLAGE and recorded in the RMC Office Greenville County, S. C., in Plat Book " K " at Page 42; and that the property lines, walls and buildings are as shown hereon, and that the walls and buildings located on said lot do not encroach or project on adjacent street or property, and that no adjacent walls or buildings encroach or project on said premises, and no power lines cross this property except as shown hereon.

12-K-31 FEB 13 1986

26792

R. B. Bruce

R. B. Bruce, RLS #1952

CAROLINA SURVEYING CO.
112 Manly St.
Greenville, S. C.

R. B. Bruce

Recordable Plat

265/49

115-5-1

3.00 3 31A01