


FILED
GREENVILLE CO., S.C.
FEB 14 1 27 PM '86
DOHNIE S. TANKERSLEY
R.M.C.

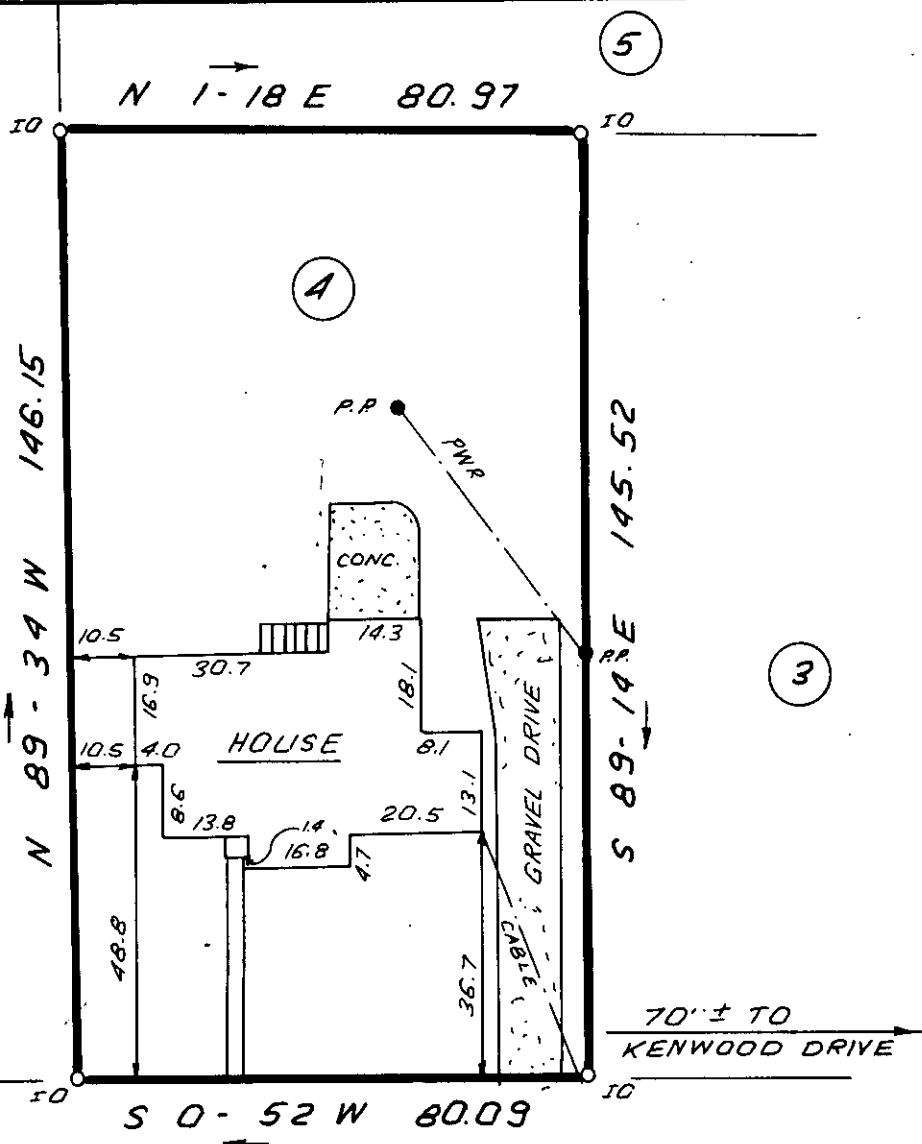


SUMMITT DRIVE FEB 14 1986

12K-34 2693-1 ✓



THIS IS TO CERTIFY THAT THE PROPERTY SHOWN ON THIS PLAT WAS SURVEYED UNDER MY DIRECT SUPERVISION. PROPERTY LINES AND IMPROVEMENTS SHOWN ARE LOCATED CORRECTLY AND THAT NO VISIBLE ENCROACHMENTS EXIST UNLESS OTHERWISE SHOWN. THIS PROPERTY IS NOT LOCATED IN A DESIGNATED FLOOD HAZARD AREA.

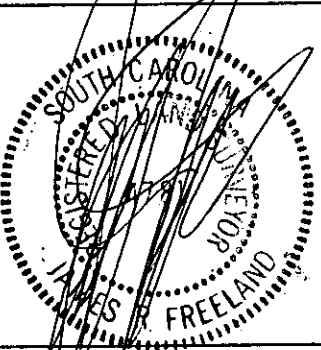

**STATE OF SOUTH CAROLINA
GREENVILLE COUNTY**

FREELAND & ASSOCIATES
Engineers • Land Surveyors
318 WEST STONE AVENUE.
GREENVILLE, S.C.
(803) 271-4924

KENWOOD PLACE
LOT 4
PROPERTY OF
J. KIRTLAND HIBBITTS
KATHERINE JOHNSTONE HIBBITTS

PLAT BOOK	K - 1048105
DEED BOOK	1202 - 379
TAX MAP	182 - 2 - 22
PARTY CHIEF	J.C.
DRAWN	I.R.
DATE	FEB. -11- 86
DWG. NO.	14622

RLS: JAMES R. FREELAND
NO: 4781

3000 1 FEB 14 86 631 3.0001