

Note: 5' Drainage & Utility easement each side all side & rear lot lines.

Note: Improvements on this lot are not in a flood hazard area.

FILED
GREENVILLE CO., S.C.

FEB 14 4 15 PM '86

DOHNIE S. TANKERSLEY
R.M.C.

BLUE MOUNTAIN DR.
WATER IN ST. R/W

12-K-38

PROPERTY OF


DARTIN LEE DARNELL

NEAR GREENVILLE, S.C.

FEB 14 1986

SCALE: 1"=60' 30 JAN 1986

26951

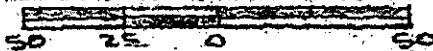

This is to certify that on the 30th day of January, 1986, I surveyed the property shown on this plat, being known as lot 63 on plat of BLUE MOUNTAIN PARK and recorded in the RMC Office Greenville County, S.C., in Plat Book "EE" at Page 121 & "III" at Page 69; and that the property lines, walls and buildings are as shown hereon, and that the walls and buildings located on said lot do not encroach or project on adjacent street or property, and that no adjacent walls or buildings encroach or project on said premises, and no power lines cross this property except as shown hereon.

R. B. Bruce
R. B. Bruce, RLS #1952

Recordable Plat