MICROFILMED

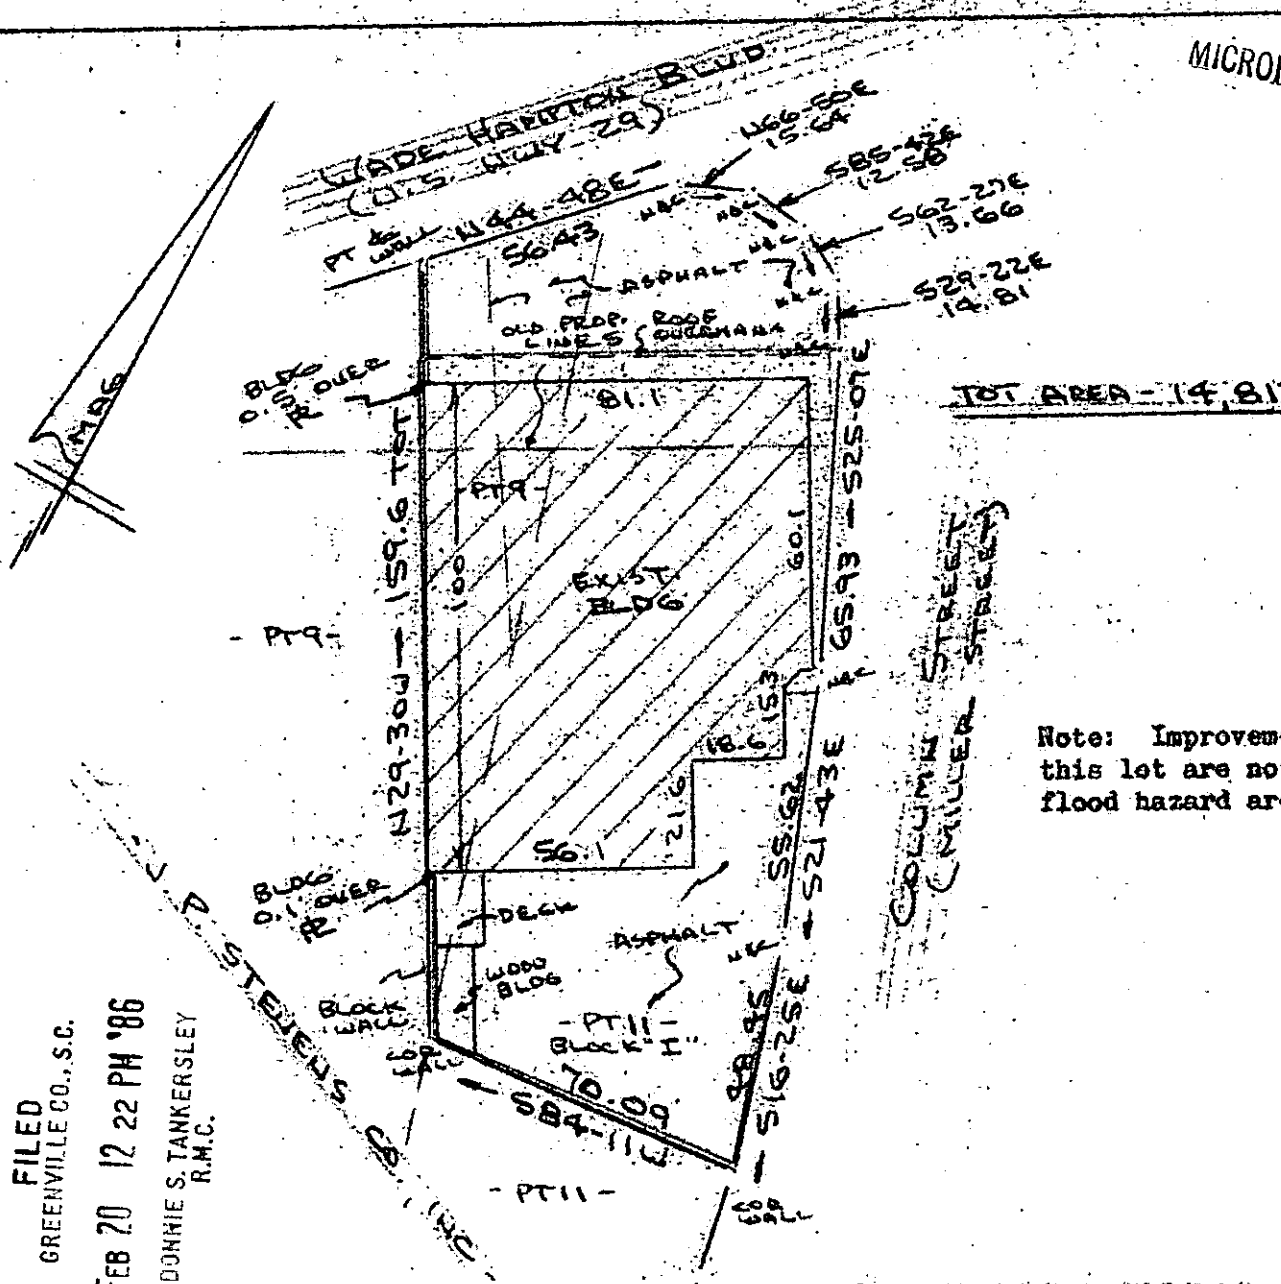

FILED
GREENVILLE CO., S.C.
FEB 20 12 22 PM '86
DONNIE S. TANKERSLEY
R.M.C.

PROPERTY OF
PATRICIA HASKELL - ROBINSON
CITY OF GREENVILLE, S.C.
SCALE 1"=40' 20 FEB 1986

40 20 0 40

This is to certify that on the 20th day of February, 1986, I surveyed the property shown on this plat, being known as part of lot 9 and part of lot 11 Block " I " on plat of STONE LAND COMPANY and recorded in the RMC Office Greenville County, S. C., in Plat Book " A " at Page 337 and Plat Book " K " at Page 277 and Plat Book " I " at Page 102 also known as PROPERTY OF PATRICIA HASKELL - ROBINSON and recorded in Plat Book at Page ; and that the property lines, walls and buildings are as shown hereon, and that the walls and buildings located on said lot do not encroach or project on adjacent street or property, and that no adjacent walls or buildings encroach or project on said premises, and no power lines cross this property except as shown hereon.

12-K-59 27454

R. B. Bruce

CAROLINA SURVEYING CO.
Greenville, S. C.

R. B. Bruce, RLS # 1952

Recordable Plat