


SEC. 2 - EDWARDS FOREST

FILED
GREENVILLE CO., S.C.

FEB 27 2 14 PM '86

DONNIE S. TANKERSLEY
R.H.C.

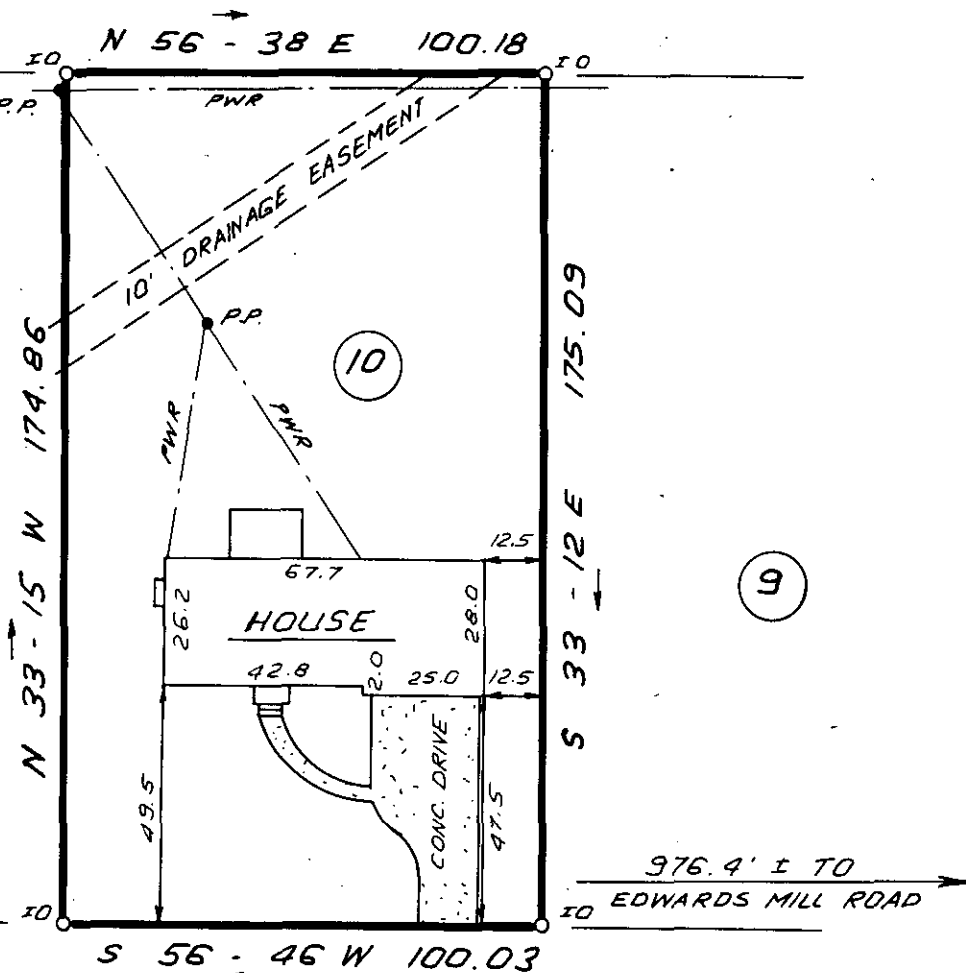


FERNWOOD DRIVE

FEB 27 1986


LUCERNE DRIVE

28143

12-K-80

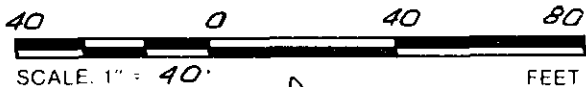

This is to certify that the property shown on this plat was surveyed under my direct supervision. Property lines and improvements shown are located correctly and that no visible encroachments exist unless otherwise shown. This property is not located in a designated flood hazard area.

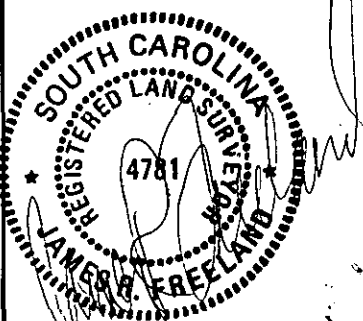

**STATE OF SOUTH CAROLINA
GREENVILLE COUNTY**

FREELAND & ASSOCIATES
Engineers • Land Surveyors
318 WEST STONE AVENUE.
GREENVILLE, S.C.
(803) 271-4924

EDWARDS FOREST
SEC. 4, LOT 10
PROPERTY OF
ROY H. SABEAN
SUSAN B. SABEAN

PLAT BOOK	JJJ - 82
DEED BOOK	
TAX MAP	T29.02-1-160
PARTY CHIEF	R.J.
DRAWN	I.R.
DATE	FEB. -24-86
DWG NO	14671

RLS: JAMES R. FREELAND
NO: 4781

5070 -- 1 FEB 27 86 1527

3.00CT