



88

89

75

73

FILED  
GREENVILLE CO., S.C.  
FEB 28 9 10 AM '86  
DONNIE S. TANKERSLEY  
R.M.C.

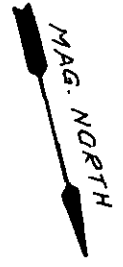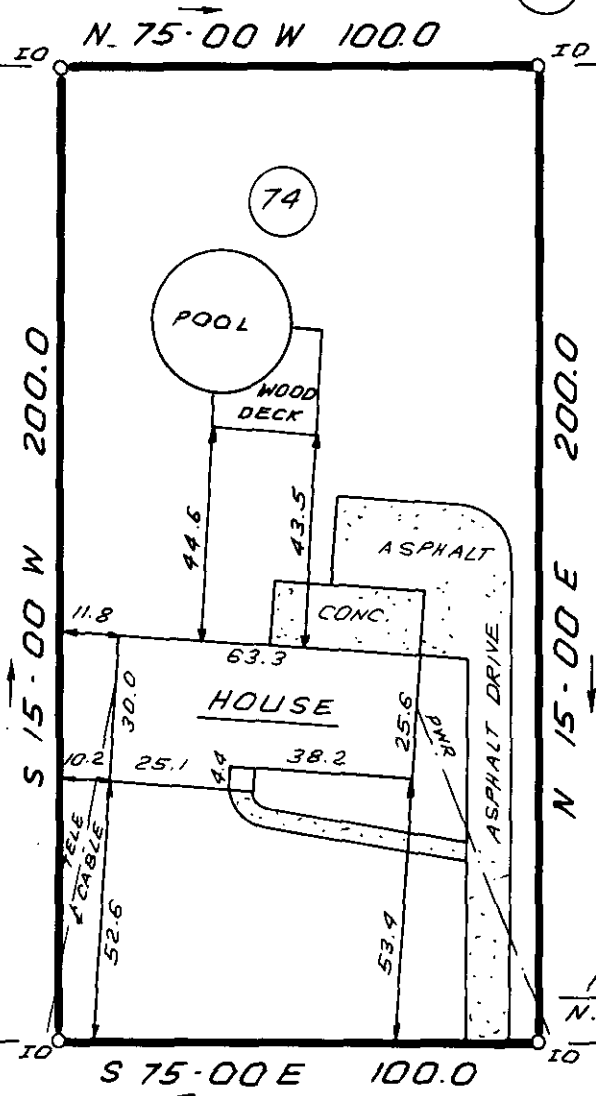

SYCAMORE DRIVE

28242

FEB 28 1986

12-K-83



This is to certify that the property shown on this plat was surveyed under my direct supervision. Property lines and improvements shown are located correctly and that no visible encroachments exist unless otherwise shown. This property is not located in a designated flood hazard area.

SOUTH CAROLINA REGISTERED LAND SURVEYOR  
4781  
JAMES R. FREELAND

R/S JAMES R. FREELAND  
NO. 4781

STATE OF SOUTH CAROLINA  
GREENVILLE COUNTY

EASTDALE DEVELOPMENT  
LOT 74  
PROPERTY OF  
ERIC D. SIPE  
CYNTHIA L. SIPE FEB 28 86

FREELAND & ASSOCIATES  
Engineers • Land Surveyors  
318 WEST STONE AVENUE.  
GREENVILLE, S.C.  
(803) 271-4924

PLAT BOOK	YY-118 & 119
DEED BOOK	1218-244
TAX MAP	M 4.3-1-76
PARTY CHIEF	J.C.
DRAWN	J.R.
DATE	FEB 29 86
DWG. NO.	14676