

MICROFILMED

FILED
GREENVILLE CO., S.C.

MAR 3 10 43 AM '86


DONNIE S. TANKERSLEY

PART LOT II

N 52.03 E 116.20



AUGUSTA COURT

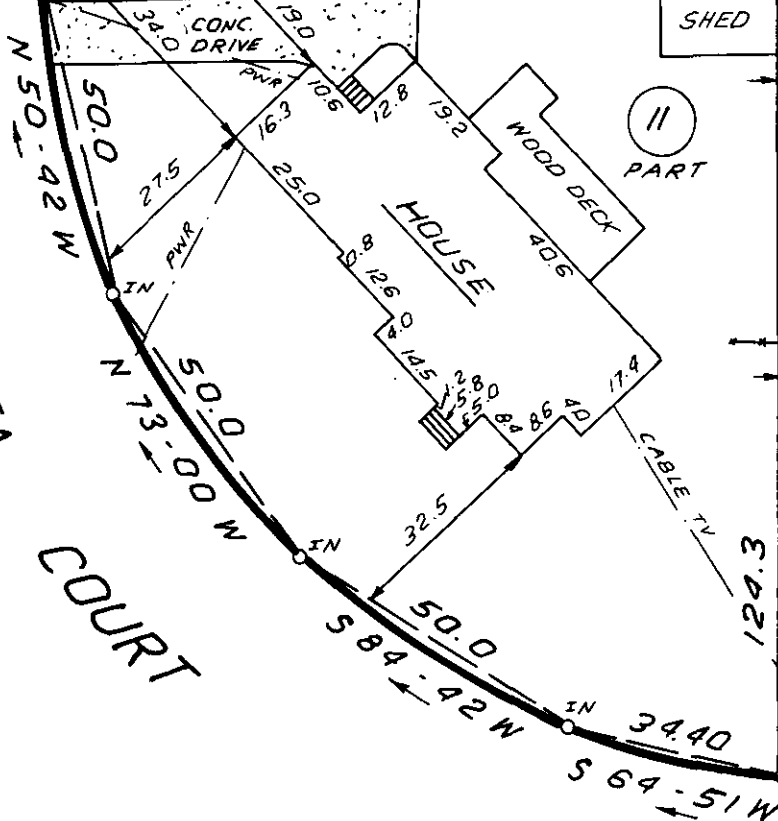

0.90'

SHED ENCROACHMENT

SHED

1.15'

11 PART

10

15' FENCE ENCROACHMENT

124.3

36" OAK

530 ± TO

AUGUSTA ROAD

12-K-98
28518

This is to certify that the property shown on this plat was surveyed under my direct supervision. Property lines and improvements shown are located correctly and that no visible encroachments exist unless otherwise shown. This property is not located in a designated flood hazard area.



STATE OF SOUTH CAROLINA
GREENVILLE COUNTY

FREELAND & ASSOCIATES
Engineers • Land Surveyors
318 WEST STONE AVENUE.
GREENVILLE, S.C.
(803) 271-4924

AUGUSTA COURT


PART LOT II

PROPERTY OF

JAMES G. TZOUVELEKAS

SALLY C. TZOUVELEKAS

| | |
|-------------|-----------|
| PLAT BOOK | F-124 |
| DEED BOOK | 1086-630 |
| TAX MAP | 214-3.000 |
| PARTY CHIEF | L.T. |
| DRAWN | I.R. |
| DATE | FEB-24-86 |
| DWG. NO. | 14667 |

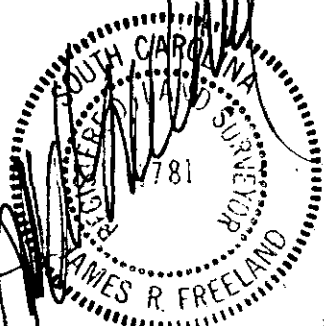

R/S JAMES R. FREELAND
NO. 4781