



FILED  
GREENVILLE CO., S.C.

MAR 4 1 15 PM '86

JOHNNIE S. TANKERSLEY  
R.M.C.

STANDING SPRINGS ROAD

SO ROAD

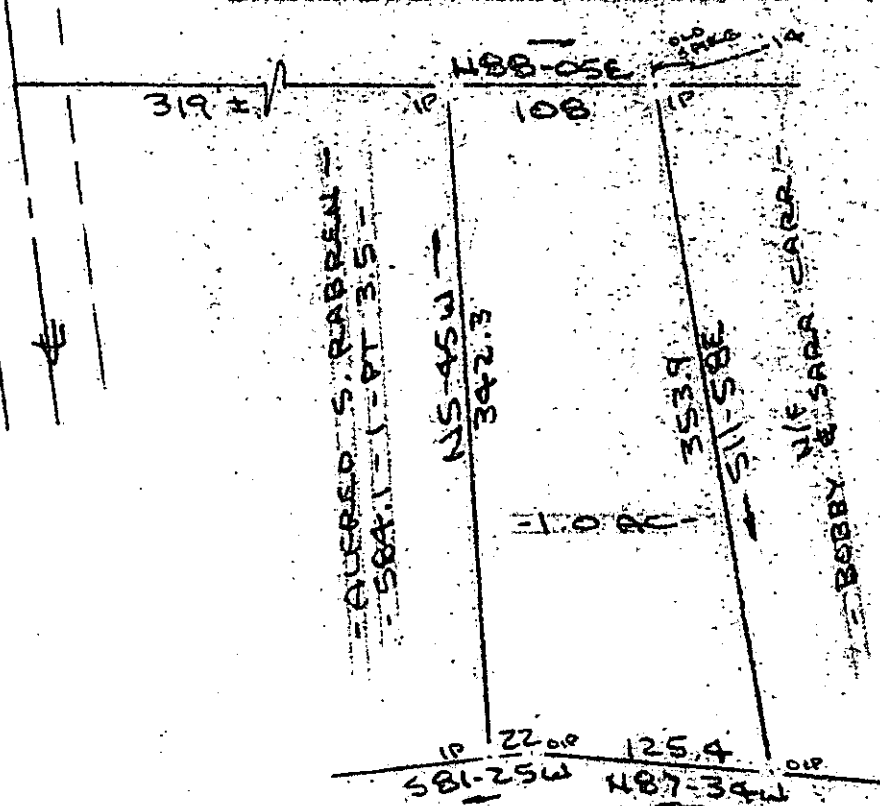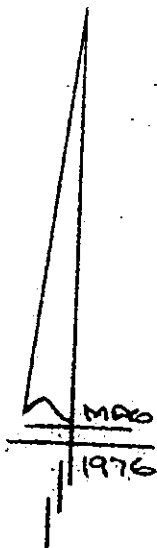

- FOUR SQUARE, A S.C. GEN. PART. -

SURVEY FOR  
DARTEL L. GILLINGHAM & MARY K. GILLINGHAM  
NEAR GREENVILLE, GREENVILLE CO., S.C.  
SCALE 1"=100' 3 MAR 1986




12-2-51

MAR 4 1986

28874

I Certify That The Ratio Of Precision Of The Field Survey  
Is 1/5000 As Shown Hereon And That The Area  
Determined By D.M.D. Method Of Area Calculations.

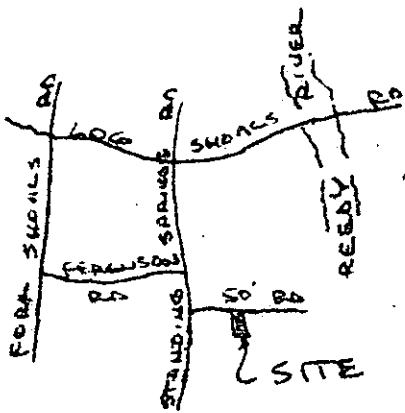

LOCATION MAP  
NO SCALE

*R. B. BRUCE*

R. B. BRUCE, PLS 1952

CAROLINA SURVEYING CO.  
112 MAIN ST.

GREENVILLE, S.C.  
GCTU 5 MAR 4 86 096

Recordable Plat

3.0000