

WOODRUFF ROAD HTS  
SUB-DIV

542-506  
171.5

0.76 AC  
TOT


SEPTIC TANK ON LOT

FILED  
GREENVILLE CO., S.C.  
MAR 7 12 23 PM '86  
DOHNIES, TANKERSLEY  
R.M.C.

CORL DRIVE

142-516 - 205.0 TOT

167.95  
167.95

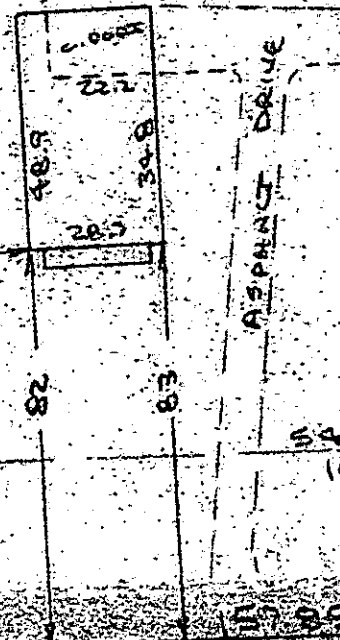

ASPHALT DRIVE

196.5 TOT - 546-434

JACK DALE

Note: Improvements on this lot are not in a flood hazard area.

WOODRUFF ROAD (15' E/W TOT)

PROPERTY OF  
JEFFERY DEAN SYKES & DIANA M. SYKES  
NEAR GREENVILLE, GREENVILLE CO., S.C.  
SCALE: 1" = 40' 3 MAR 1986



This is to certify that on the 3rd day of March, 1986, I surveyed the property shown on this plat, being known as 0.76 acre on plat of PROPERTY OF JEFFERY DEAN SYKES, & DIANA M. SYKES and recorded in the REC Office Greenville County, S. C., in Plat Book at Page ; and that the property lines, walls and buildings are as shown hereon, and that the walls and buildings located on said lot do not encroach or project on adjacent street or property, and that no adjacent walls or buildings encroach or project on said premises, and no power lines cross this property and no visible encroachments except as shown hereon.

12-6-75 29266

R. B. Bruce, RLS # 1986  
R. B. Bruce

MAR 7 1986

CAROLINA SURVEYING CO.  
Greenville, S. C.

Recordable Plat