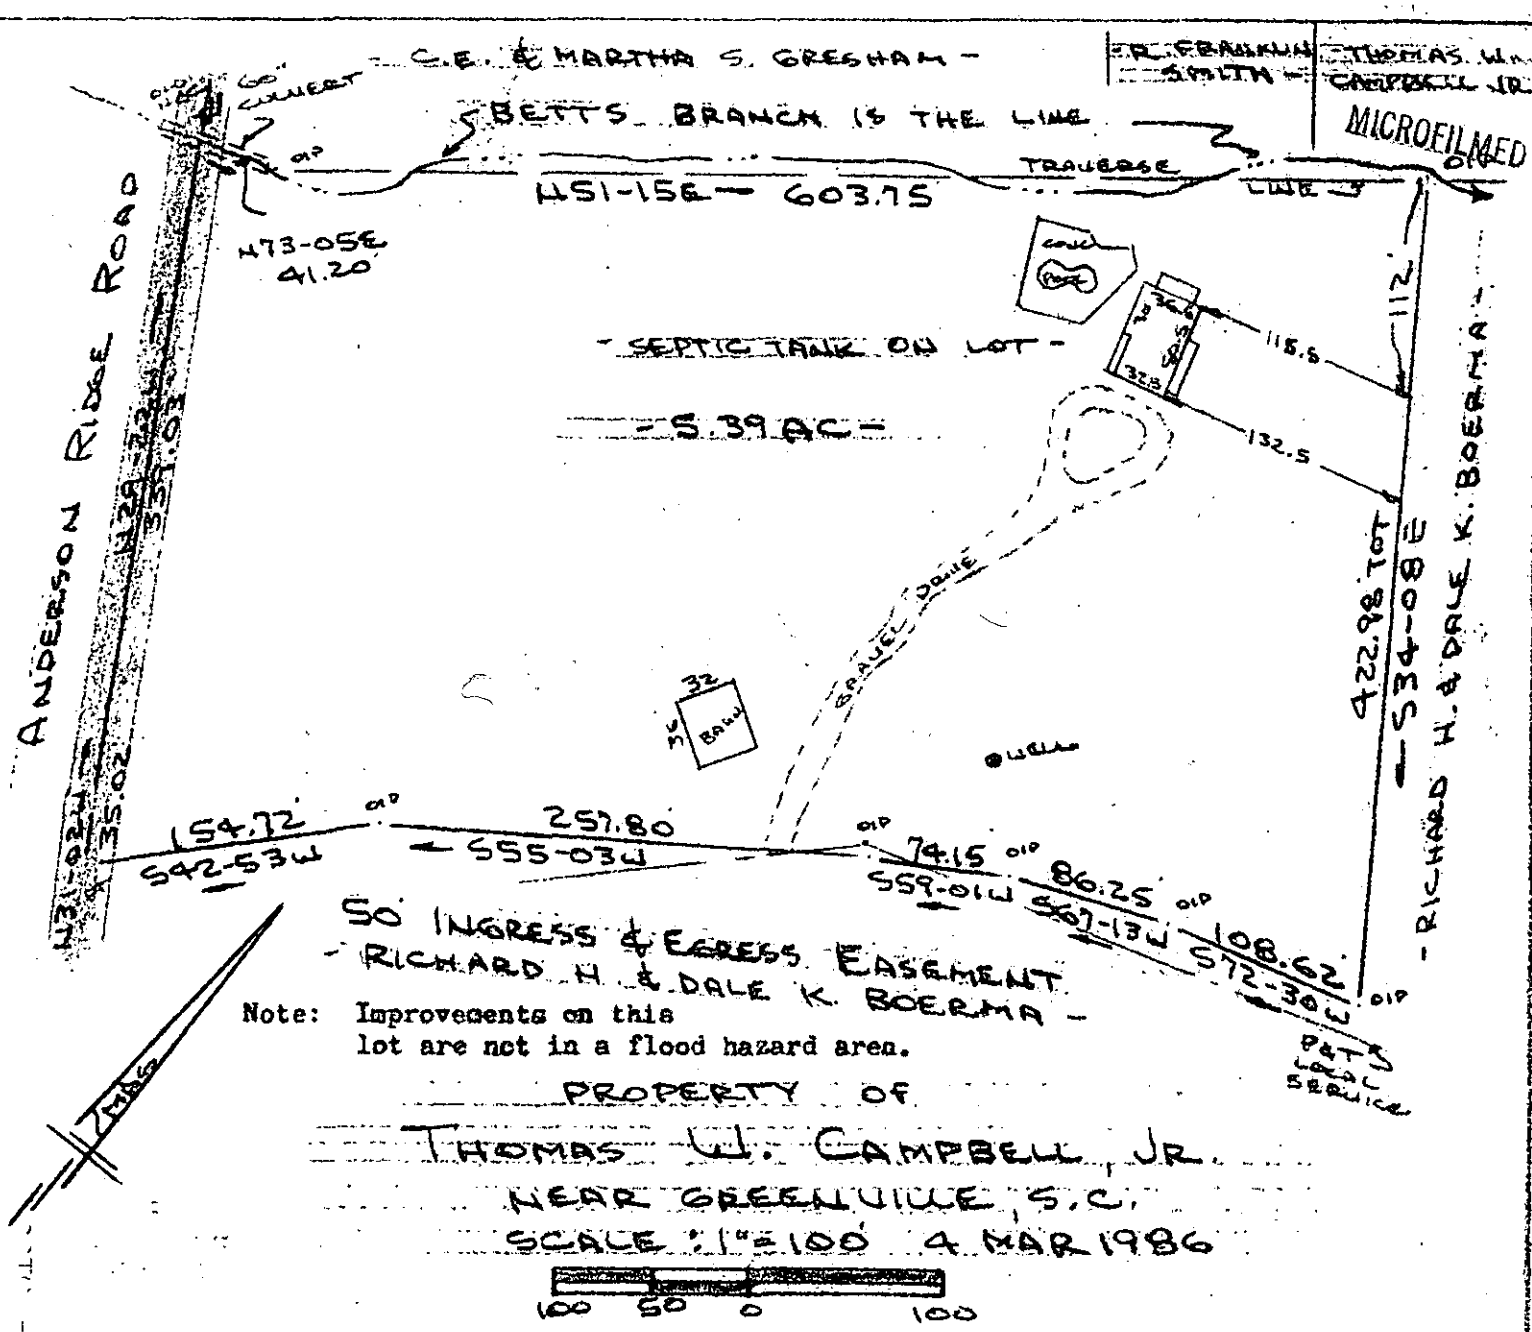

Note: Improvements on this lot are not in a flood hazard area.

PROPERTY OF

THOMAS W. CAMPBELL, JR.

NEAR GREENVILLE, S.C.

SCALE: 1"=100' 4 MAR 1986

This is to certify that on the 4th day of March, 1986, I surveyed the property shown on this plat, being known as 5.39 acres on plat of THOMAS W. CAMPBELL, JR. and recorded in the RMC Office Greenville County, S. C., in Plat Book " 9 - K " at Page 49; and that the property lines, walls and buildings located on said lot do not encroach or project on adjacent street or property, and that no adjacent walls or buildings encroach or project on said premises, and no power lines cross this property and no visible encroachments except as shown hereon.

12-6-100 29629

R. B. Bruce

R. B. Bruce, RLS # 1952

CAROLINA SURVEYING CO.
112 Manly St.
Greenville, S. C.

FILED
GREENVILLE CO., S.C.
MAR 11 12 35 PM '86
DONNIE S. TANKERSLEY
R.M.C.

Recordable Plat

2 MR11 86 1081

3.00CI