MICROFILMED

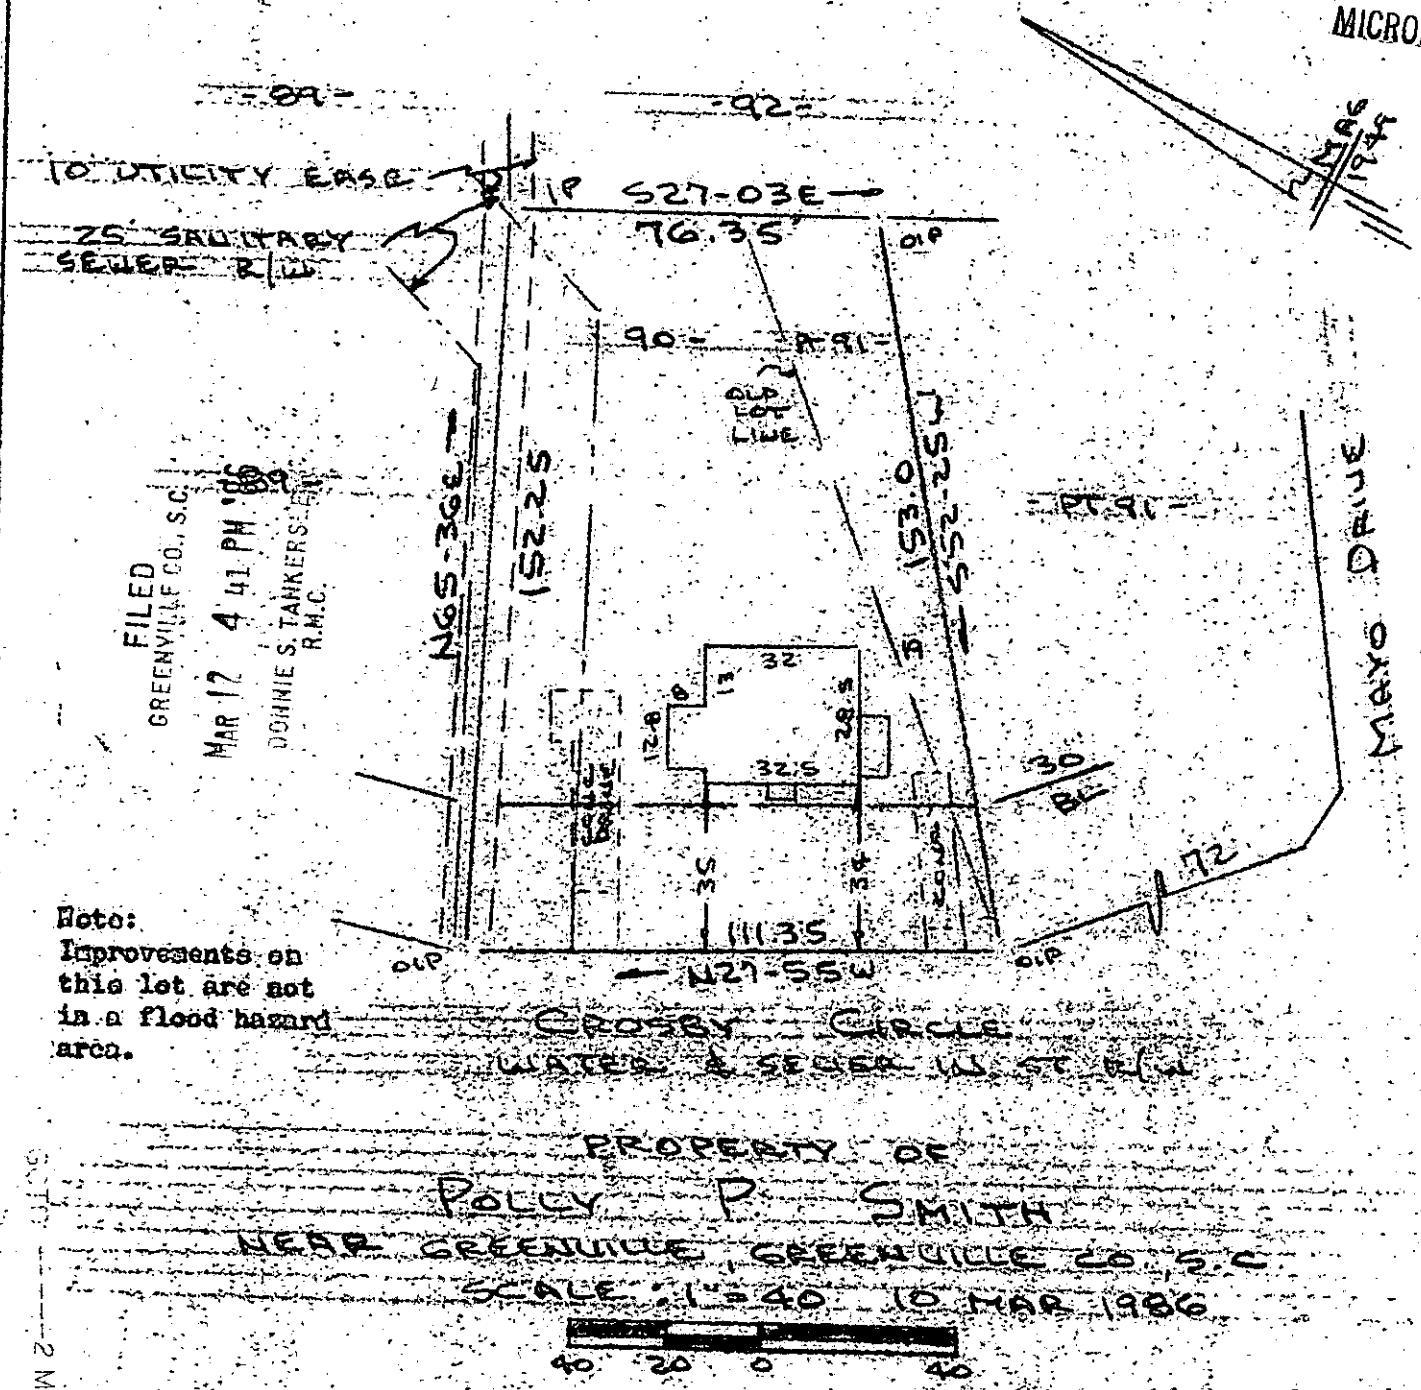

FILED
GREENVILLE CO., S.C.
MAR 12 4 41 PM '86
DONNIE S. TANKERSLEY
R.M.C.

Note:
Improvements on this lot are not in a flood hazard area.

This is to certify that on the 10th day of March, 1986, I surveyed the property shown on this plat, being known as lot 90 & part of lot 91 on plat of PARAMOUNT PARK and recorded in the RMC Office Greenville County, S. C., in Plat Book " A " at Page 57 and also known as PROPERTY OF POLLY P. SMITH and recorded in Plat Book at Page ; and that the property lines, walls and buildings are as shown hereon, and that the walls and buildings located on said lot do not encroach or project on adjacent street or property, and that no adjacent walls or buildings encroach or project on said premises, no power lines cross this property and no visible encroachments except as shown hereon.

12N-3

MAR 12 1986

29838

H. B. Bruce, Reg. No. 1952

CAROLINA SURVEYING CO.
Greenville, S. C.

Recordable Plat

298/44