
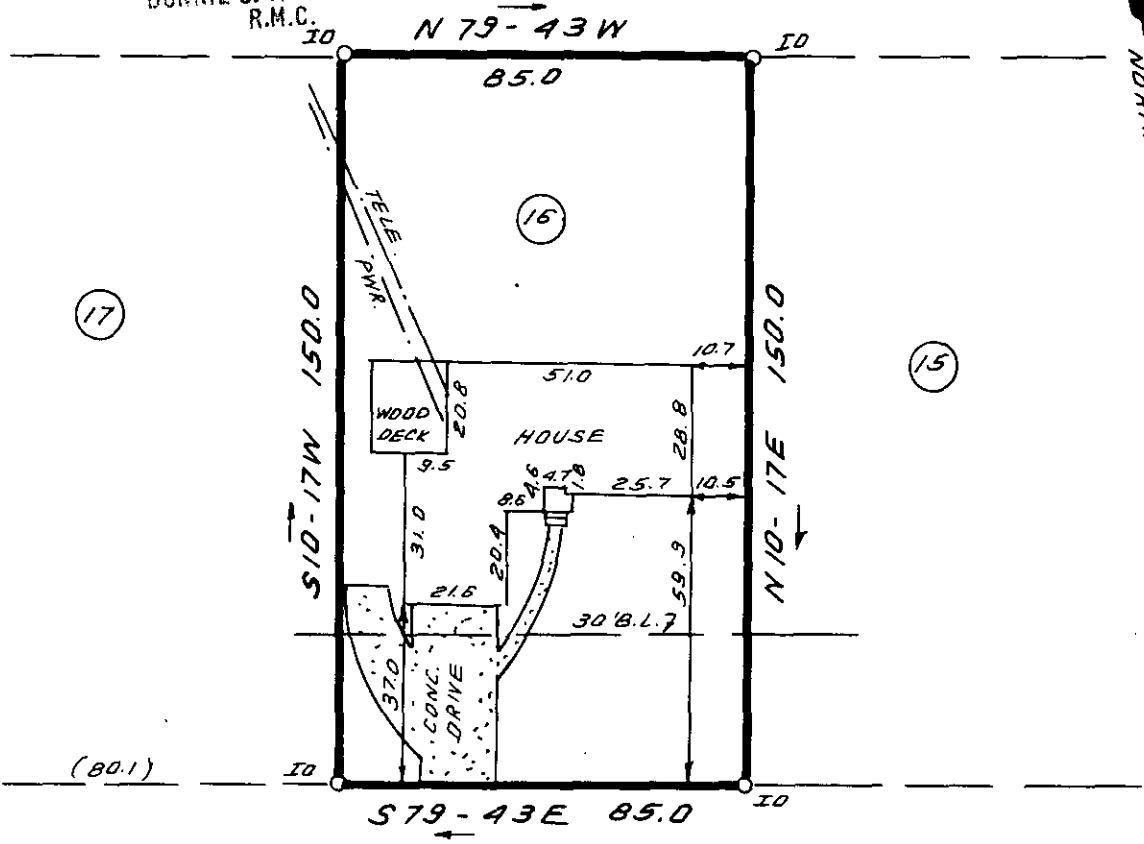


FILED
GREENVILLE CO., S.C.

MAR 18 10 10 AM '86

DONNIE S. TANKERSLEY
R.M.C.

BLACKGUM COURT

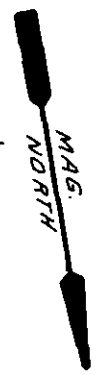

BROOK BEND ROAD

MAR 18 1986



12-N-30 30455


THIS IS TO CERTIFY THAT THE PROPERTY SHOWN ON THIS PLAT WAS SURVEYED UNDER MY DIRECT SUPERVISION PROPERTY LINES AND IMPROVEMENTS SHOWN ARE LOCATED CORRECTLY AND THAT NO VISIBLE ENCROACHMENTS EXIST UNLESS OTHERWISE SHOWN. THIS PROPERTY IS NOT LOCATED IN A DESIGNATED FLOOD HAZARD AREA

5 00X

STATE OF SOUTH CAROLINA
GREENVILLE COUNTY

FREELAND-CLINKSCALES
& ASSOCIATES, INC.

Engineers • Land Surveyors
323 WEST STONE AVENUE
GREENVILLE, S.C.
(803) 271-4924

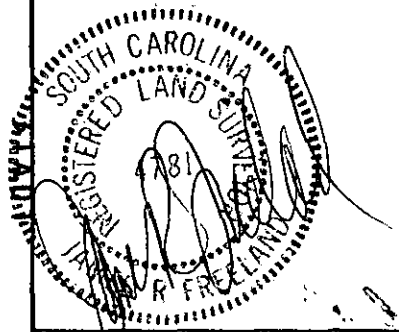

HOLLY SPRINGS
SEC. ONE ; LOT 16
PROPERTY OF
MARK ALLEN GORDON
TERRY FLOYD GORDON

PLAT BOOK	4N-5
DEED BOOK	1021 - 616
TAX MAP	546.2-1-15
PARTY CHIEF	J. G.
DRAWN	B. R.
DATE	3-17-86
DWG NO.	14783

RLS JAMES R. FREELAND
NO. 4781