



-110-

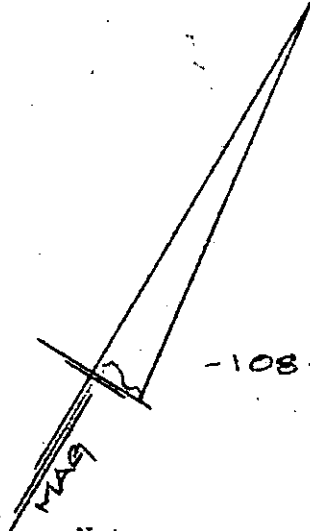

Note:  
Improvements  
on this lot  
are not in a  
flood hazard  
area.

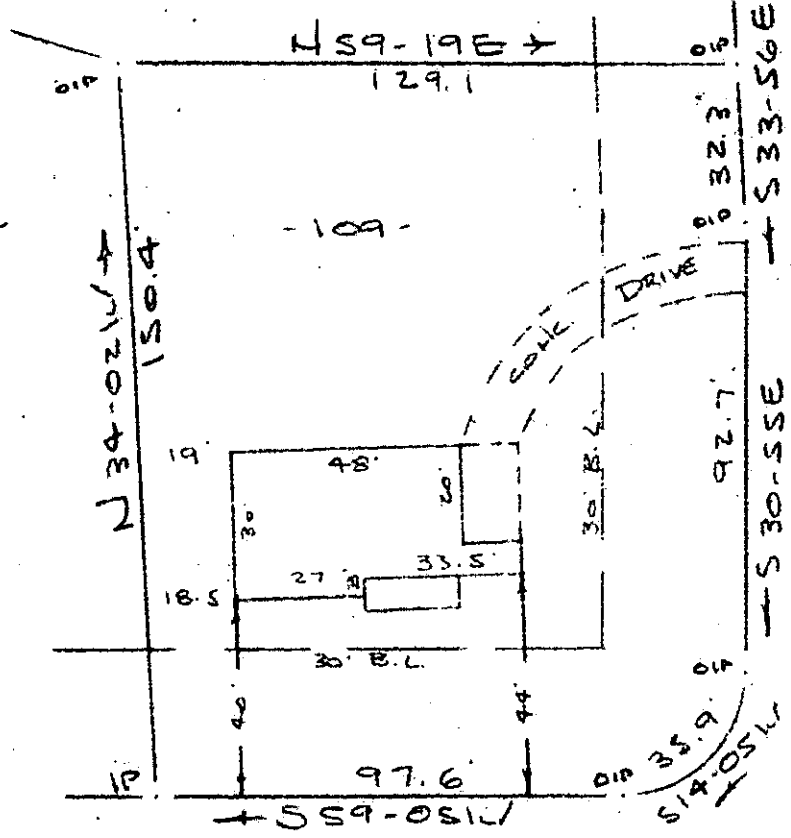

LONGWOOD DRIVE  
WATER & SEWER IN ST. R/W

FILED  
GREENVILLE CO., S.C.

MAR 25 11 05 AM '86

JOHNNIE S. TANKERSLEY  
R.M.C.

MERRYWOOD DRIVE  
WATER & SEWER IN ST. R/W

PROPERTY OF

JAMES H. ROBERTS & JACQUELINE F. ROBERTS

NEAR GREENVILLE, S.C.

SCALE 1" = 40' 21 MAR. 1986

This is to certify that on the 21st day of Mar, 1986, I surveyed the property shown on this plat, being known as lot 109 on plat of Plat No. Two THORNWOOD ACRES and recorded in the RMC Office Greenville County, S. C., in Plat Book "M4" at Page 105; and that the property lines, walls and buildings are as shown hereon, and that the walls and buildings located on said lot do not encroach or project on adjacent street or property, and that no adjacent walls or buildings encroach or project on said premises, and no power lines cross this property except as shown hereon.

12-N-53

31251

R. B. [Signature]

R. B. [Signature]

MAR 25 1986

CAROLINA SURVEYING CO.  
112 Manly St.  
Greenville, S.C.

Recordable Plat

SC70 -- 1 MR25 86 420 3.00CI

2251

Plat - 1 - 749

1000