

MICROFILMED  
25' EASEMENT  
FOR SEWER

MAR 1972

Note:  
Improvements on this lot are not in a flood hazard area.

Note:  
There is a 5' drainage & utilities easement along each side and rear lot line.

RIDDLE ROAD


FILED  
GREENVILLE CO., S.C.

98 AM 3 24 PM '86

ANNIE S. TANKERSLEY  
R.M.C.

RICHARD WHIDDON

PROPERTY OF  
WHIDDON & CARRIE WHIDDON  
NEAR GREENVILLE S.C.  
SCALE: 1"=40' 25 MAR 1986

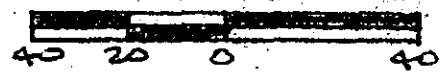

MAR 27 1986

This is to certify that on the 25th day of March, 1986, I surveyed the property shown on this plat, being known as lot 157 on plat of PINE BROOK FOREST SUBDIVISION and recorded in the RMC Office Greenville County, S. C., in Plat Book " 4 - X " at Page 49 and also known as PROPERTY OF RICHARD WHIDDON & CARRIE WHIDDON and recorded in Plat Book at Page ; and that the property lines, walls and buildings are as shown hereon, and that the walls and buildings located on said lot do not encroach or project on adjacent street or property, and that no adjacent walls or buildings encroach or project on said premises, no power lines cross this property and no visible encroachments except as shown hereon.

12-N-69


MAR 27 1986

R. B. Bruce, RLS

31545

CAROLINA SURVEYING CO.  
112 Manly St.  
Greenville, S. C.

Recordable Plat

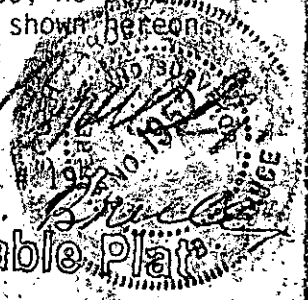

2 MR 27 86

877

3.00CI

302/50A

574 (1-1-15)