


Note: Improvements on this lot are not in a flood hazard area.

CURETON STREET

PROPERTY OF  
 ARTHUR R. CONNELLY & JEANNE W. CONNELLY  
 CITY OF GREENVILLE, S.C.

SCALE: 1" = 40' 24 MAR 1986

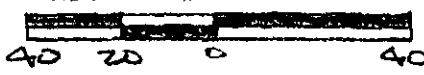

31686

This is to certify that on the 24th day of March, 1986, I surveyed the property shown on this plat, being known as lot 14 Block " F " on plat of KANATENAH and recorded in the RMC Office Greenville County, S. C., in Plat Book " F " at Pages 130 & 131 and also known as PROPERTY OF ARTHUR R. CONNELLY & JEANNE W. CONLEY and recorded in the RMC Office Plat Book at Page ; and that the property lines, walls and buildings are as shown hereon, and that the walls and buildings located on said lot do not encroach or project on adjacent street or property, and that no adjacent walls or buildings encroach or project on said premises, no power lines cross this property and no visible encroachments except as shown hereon.

FILED  
 GREENVILLE CO., S.C.  
 MAR 28 11 54 AM '86  
 DONNIE S. TANKERSLEY  
 R.M.C.

12-N-75

R. B. Bruce, R.L.S.  
 R. B. Bruce, R.L.S.

CAROLINA SURVEYING CO.  
 112 Manly St.  
 Greenville, S. C.

