MICROFILMED

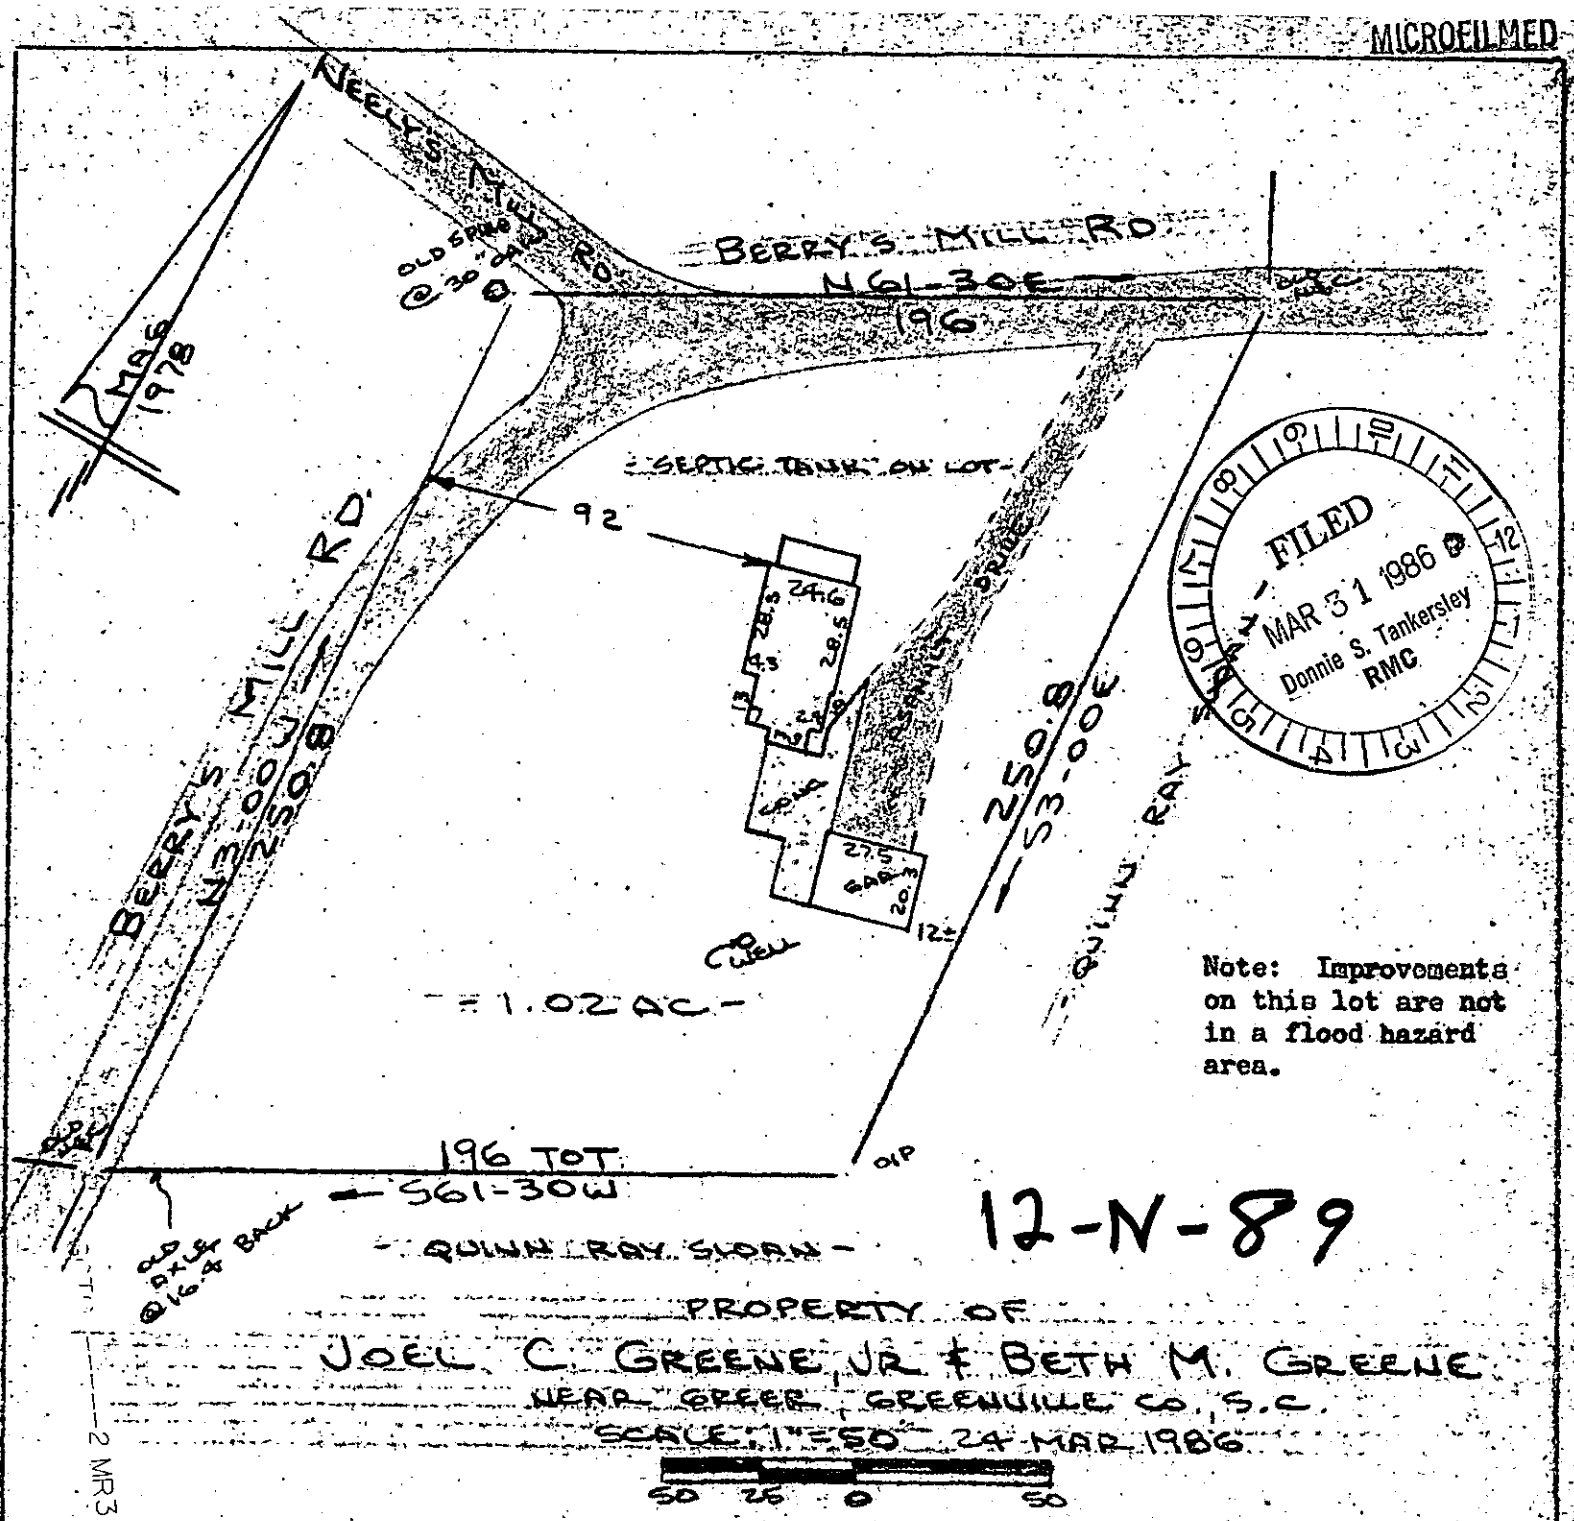

FILED
MAR 31 1986
Donnie S. Tankersley
RMC

Note: Improvements on this lot are not in a flood hazard area.

12-N-89

PROPERTY OF
JOEL C. GREENE, JR & BETH M. GREENE
NEAR GREER, GREENVILLE CO., S.C.
SCALE: 1"=50' 24 MAR 1986

50 25 0 50

2 MR31 86 1118

This is to certify that on the 24th day of March, 1986, I surveyed the property shown on this plat, being known as 1.02 acres on plat of H. A. LYNCH and recorded in the RMC Office Greenville County, S. C., in Plat Book " 6 - X " at Page 38; and that the property lines, walls and buildings are as shown hereon, and that the walls and buildings located on said lot do not encroach or project on adjacent street or property, and that no adjacent walls or buildings encroach or project on said premises, and no power lines cross this property except as shown hereon.

Also known as PROPERTY OF JOEL C. GREENE, JR. & BETH M. GREENE and recorded in Plat Book at Page .

31841

R. B. Bruce

R. B. Bruce, RLS #1952

CAROLINA SURVEYING CO.
112 Manly St.
Greenville, S. C.

Recordable Plat

3.00CI