


FILED
 GREENVILLE, S.C.
 MAR 31 4 13 PM '86
 DONNIE S. TANKERSLEY
 R.M.G.

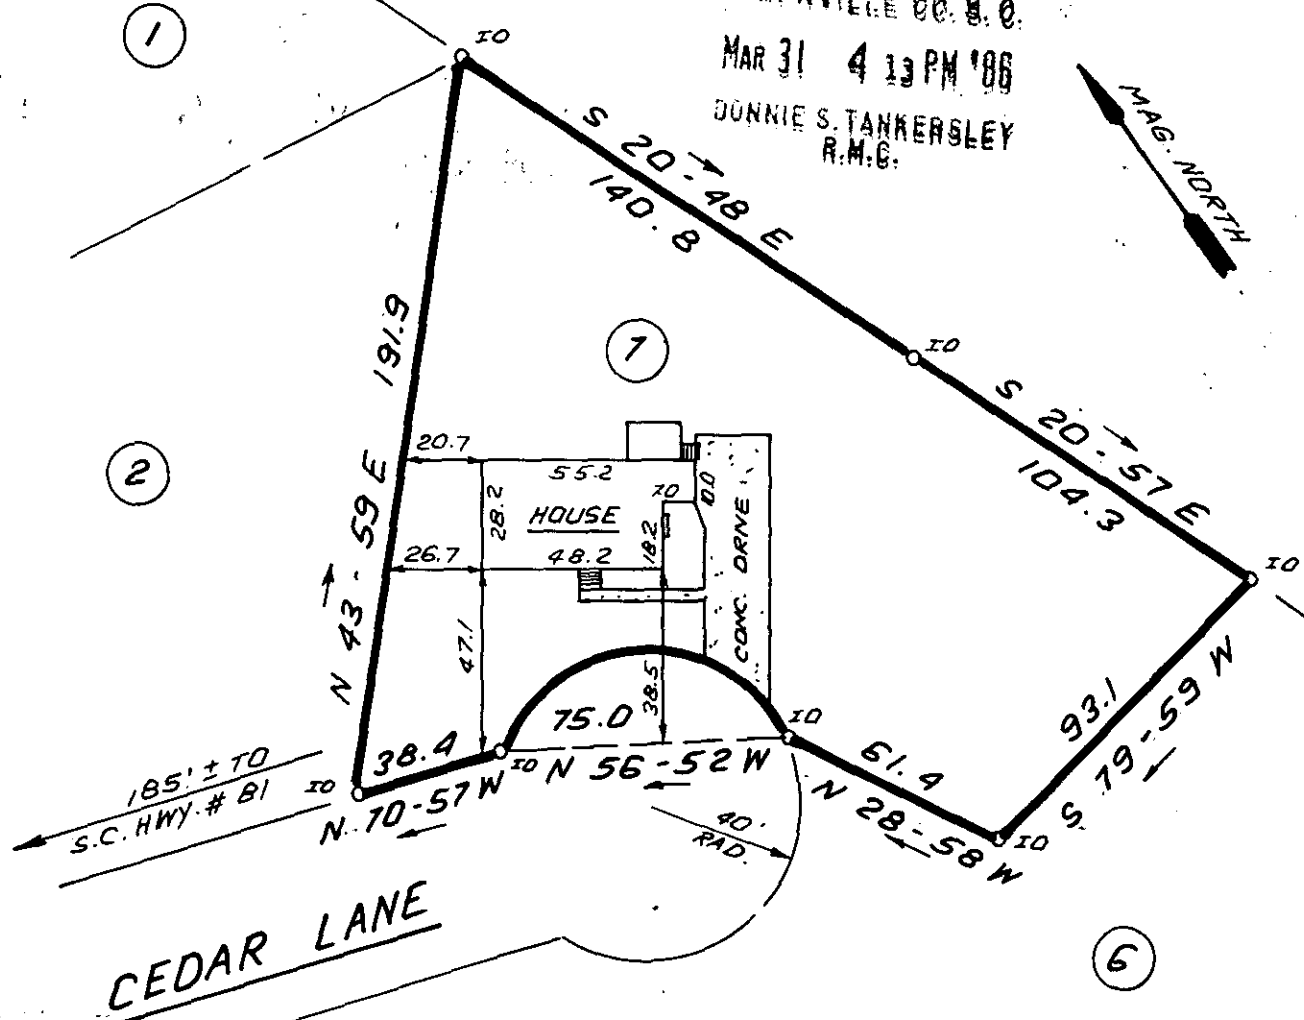

NOTE: 5' DRAINAGE AND UTILITY EASEMENT ALONG ALL SIDE AND REAR LOT LINES.

31989

MAR 31 1986

✓ 12-N-96



THIS IS TO CERTIFY THAT THE PROPERTY SHOWN ON THIS PLAT WAS SURVEYED UNDER MY DIRECT SUPERVISION. PROPERTY LINES AND IMPROVEMENTS SHOWN ARE LOCATED CORRECTLY AND THAT NO VISIBLE ENCROACHMENTS EXIST UNLESS OTHERWISE SHOWN. THIS PROPERTY IS NOT LOCATED IN A DESIGNATED FLOOD HAZARD AREA.

SOUTH CAROLINA
 REGISTERED LAND SURVEYOR
 No. 4781
 JAMES RALPH FREELAND
 RLS: JAMES R. FREELAND
 NO: 4781

STATE OF SOUTH CAROLINA
ANDERSON COUNTY
CEDAR ACRES
LOT 7
PROPERTY OF
CLYDE PAUL MOORE
CYNTHIA H. MOORE

FREELAND-CLINKSCALES & ASSOCIATES, INC.
 Engineers • Land Surveyors
 323 WEST STONE AVENUE
 GREENVILLE, S.C.
 (803) 271-4924

PLAT BOOK	
DEED BOOK	
TAX MAP	
PARTY CHIEF	B.C.
DRAWN	I.R.
DATE	MARCH - 31 - 86
DWG NO.	14881