

FILED
 GREENVILLE CO. S.C.
 APR 7 2 36 PM '86
 DONNIE S. TANKERSLEY
 R.M.C.

NOTES: IRON PINS AT ALL PROPERTY CORNERS.

DRAINAGE AND UTILITY EASEMENT 5'
 EACH SIDE OF ALL SIDE AND REAR
 LOT LINES.

This is to certify that on April 02, 1986, I surveyed the property shown on this plat, known as Lot 269 on plat of Hunters Woods, Section 2, Phase 1, recorded in the R.M.C. Office of Greenville County, in Plat Book III at Page 10, and that the property lines, walls and buildings are as shown hereon, that the building located on said lot does not encroach or project on adjacent streets or property, and that no adjacent walls or buildings encroach or project on said premises, and that no utility R/W's cross this property except as shown hereon. According to the Flood Rate Insurance Map and to the best of my knowledge, this structure is not in an Established Flood Zone.

12-0-32 APR 7 1986
 32855




THIS PROPERTY IS SUBJECT TO ANY AND ALL RIGHTS OF WAY AND EASEMENTS OF RECORD.

LANDRITH SURVEYING

Land Surveys - Topographical Maps
 Construction Layout

628-C WADE HAMPTON BLVD.
 GREENVILLE, S.C. 29609
 (803) 271-8536

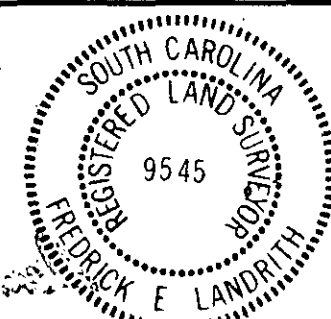

STATE of SOUTH CAROLINA
 COUNTY of GREENVILLE

HUNTERS WOODS
 SECTION 2, PHASE I, LOT 269

SURVEY FOR

JOHN A. WADE
 CATHY C. WADE

SURVEYED BY EAS/JKD CHK'D BY FEL/JMW

DRAWN BY TLM DATE 04/03/86

SEAL

PROJECT NO. 86 - 658