MICROFILMED

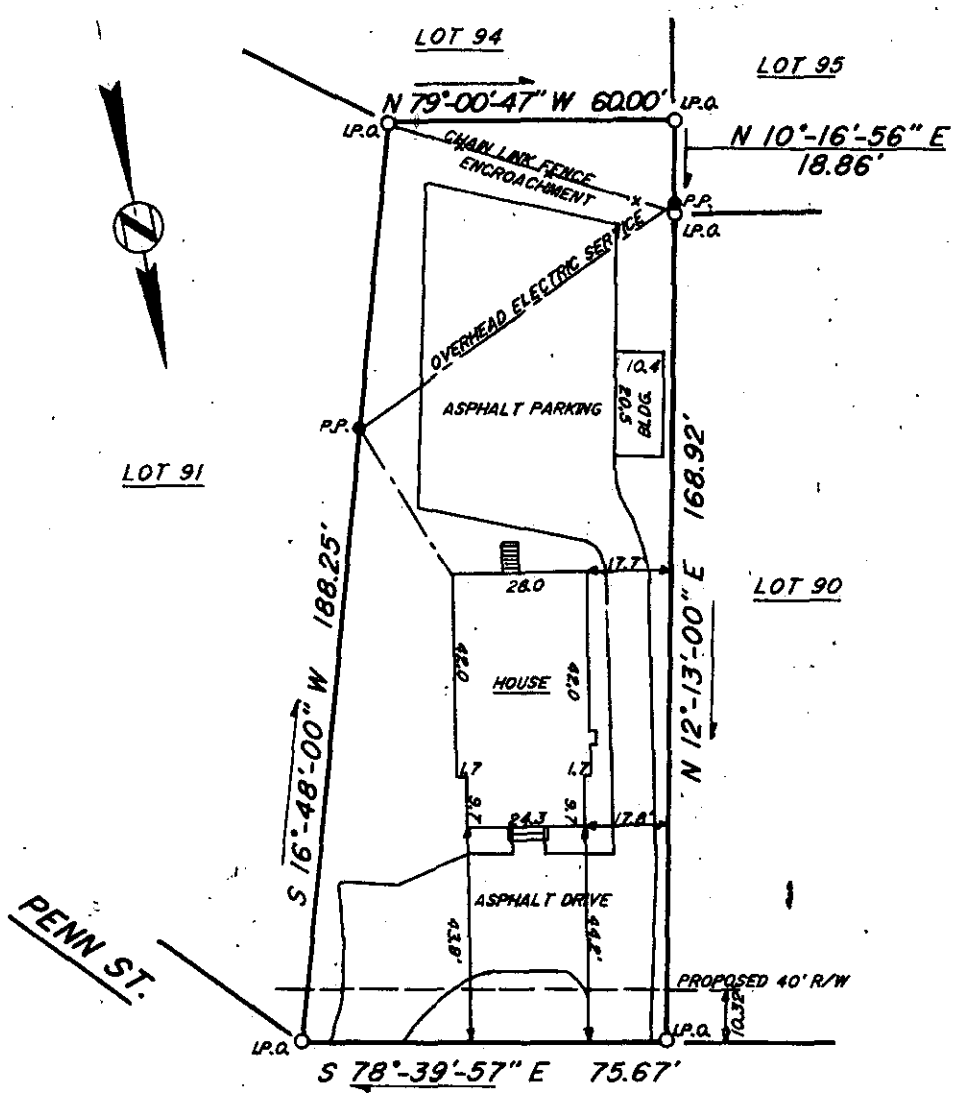

WEST POINSETT DR.

This is to certify that on April 03, 1986, I surveyed the property shown on this plat, known as the Estes Howell Lot on plat of the W.H. Brockman Estate, recorded in the R.M.C. Office of Greenville County, in Plat Book H at Page 132, and that the property lines, walls and buildings are as shown hereon, that the building located on said lot does not encroach or project on adjacent streets or property, and that no adjacent walls or buildings encroach or project on said premises, and that no utility R/W's cross this property except as shown hereon. According to the Flood Rate Insurance Map and to the best of my knowledge, this structure is not in an Established Flood Zone.

34467

12-0-91

APR 21 1986

Fredrick E. Landrith RLS 9545

THIS PROPERTY IS SUBJECT TO ANY AND ALL RIGHTS OF WAY AND EASEMENTS OF RECORD.

FILED
GREENVILLE CO. S.C.
APR 21 10 33 AM '86
DONNIE S. TANKERSLEY
R.M.C.

LANDRITH SURVEYING
Land Surveys - Topographical Maps
Construction Layout
628-C WADE HAMPTON BLVD.
GREENVILLE, S.C. 29609
(803) 271-8536

40 0 40

SOUTH CAROLINA REGISTERED LAND SURVEYOR 9545 FREDRICK E. LANDRITH

STATE of SOUTH CAROLINA
COUNTY of GREENVILLE

SURVEY FOR

STEVEN L. GAMBRELL, JR.

SURVEYED BY JMW	CHK'D BY FEL		
DRAWN BY JMW	DATE APR 04, 1986	SEAL	PROJECT NO. 86-661

THE PRINT MACHINE, INC. N74744