FILED
GREENVILLE CO. S.C.
MAY 28 4 47 PM '86
DONNIE S. TANKERSLEY
R.M.C.

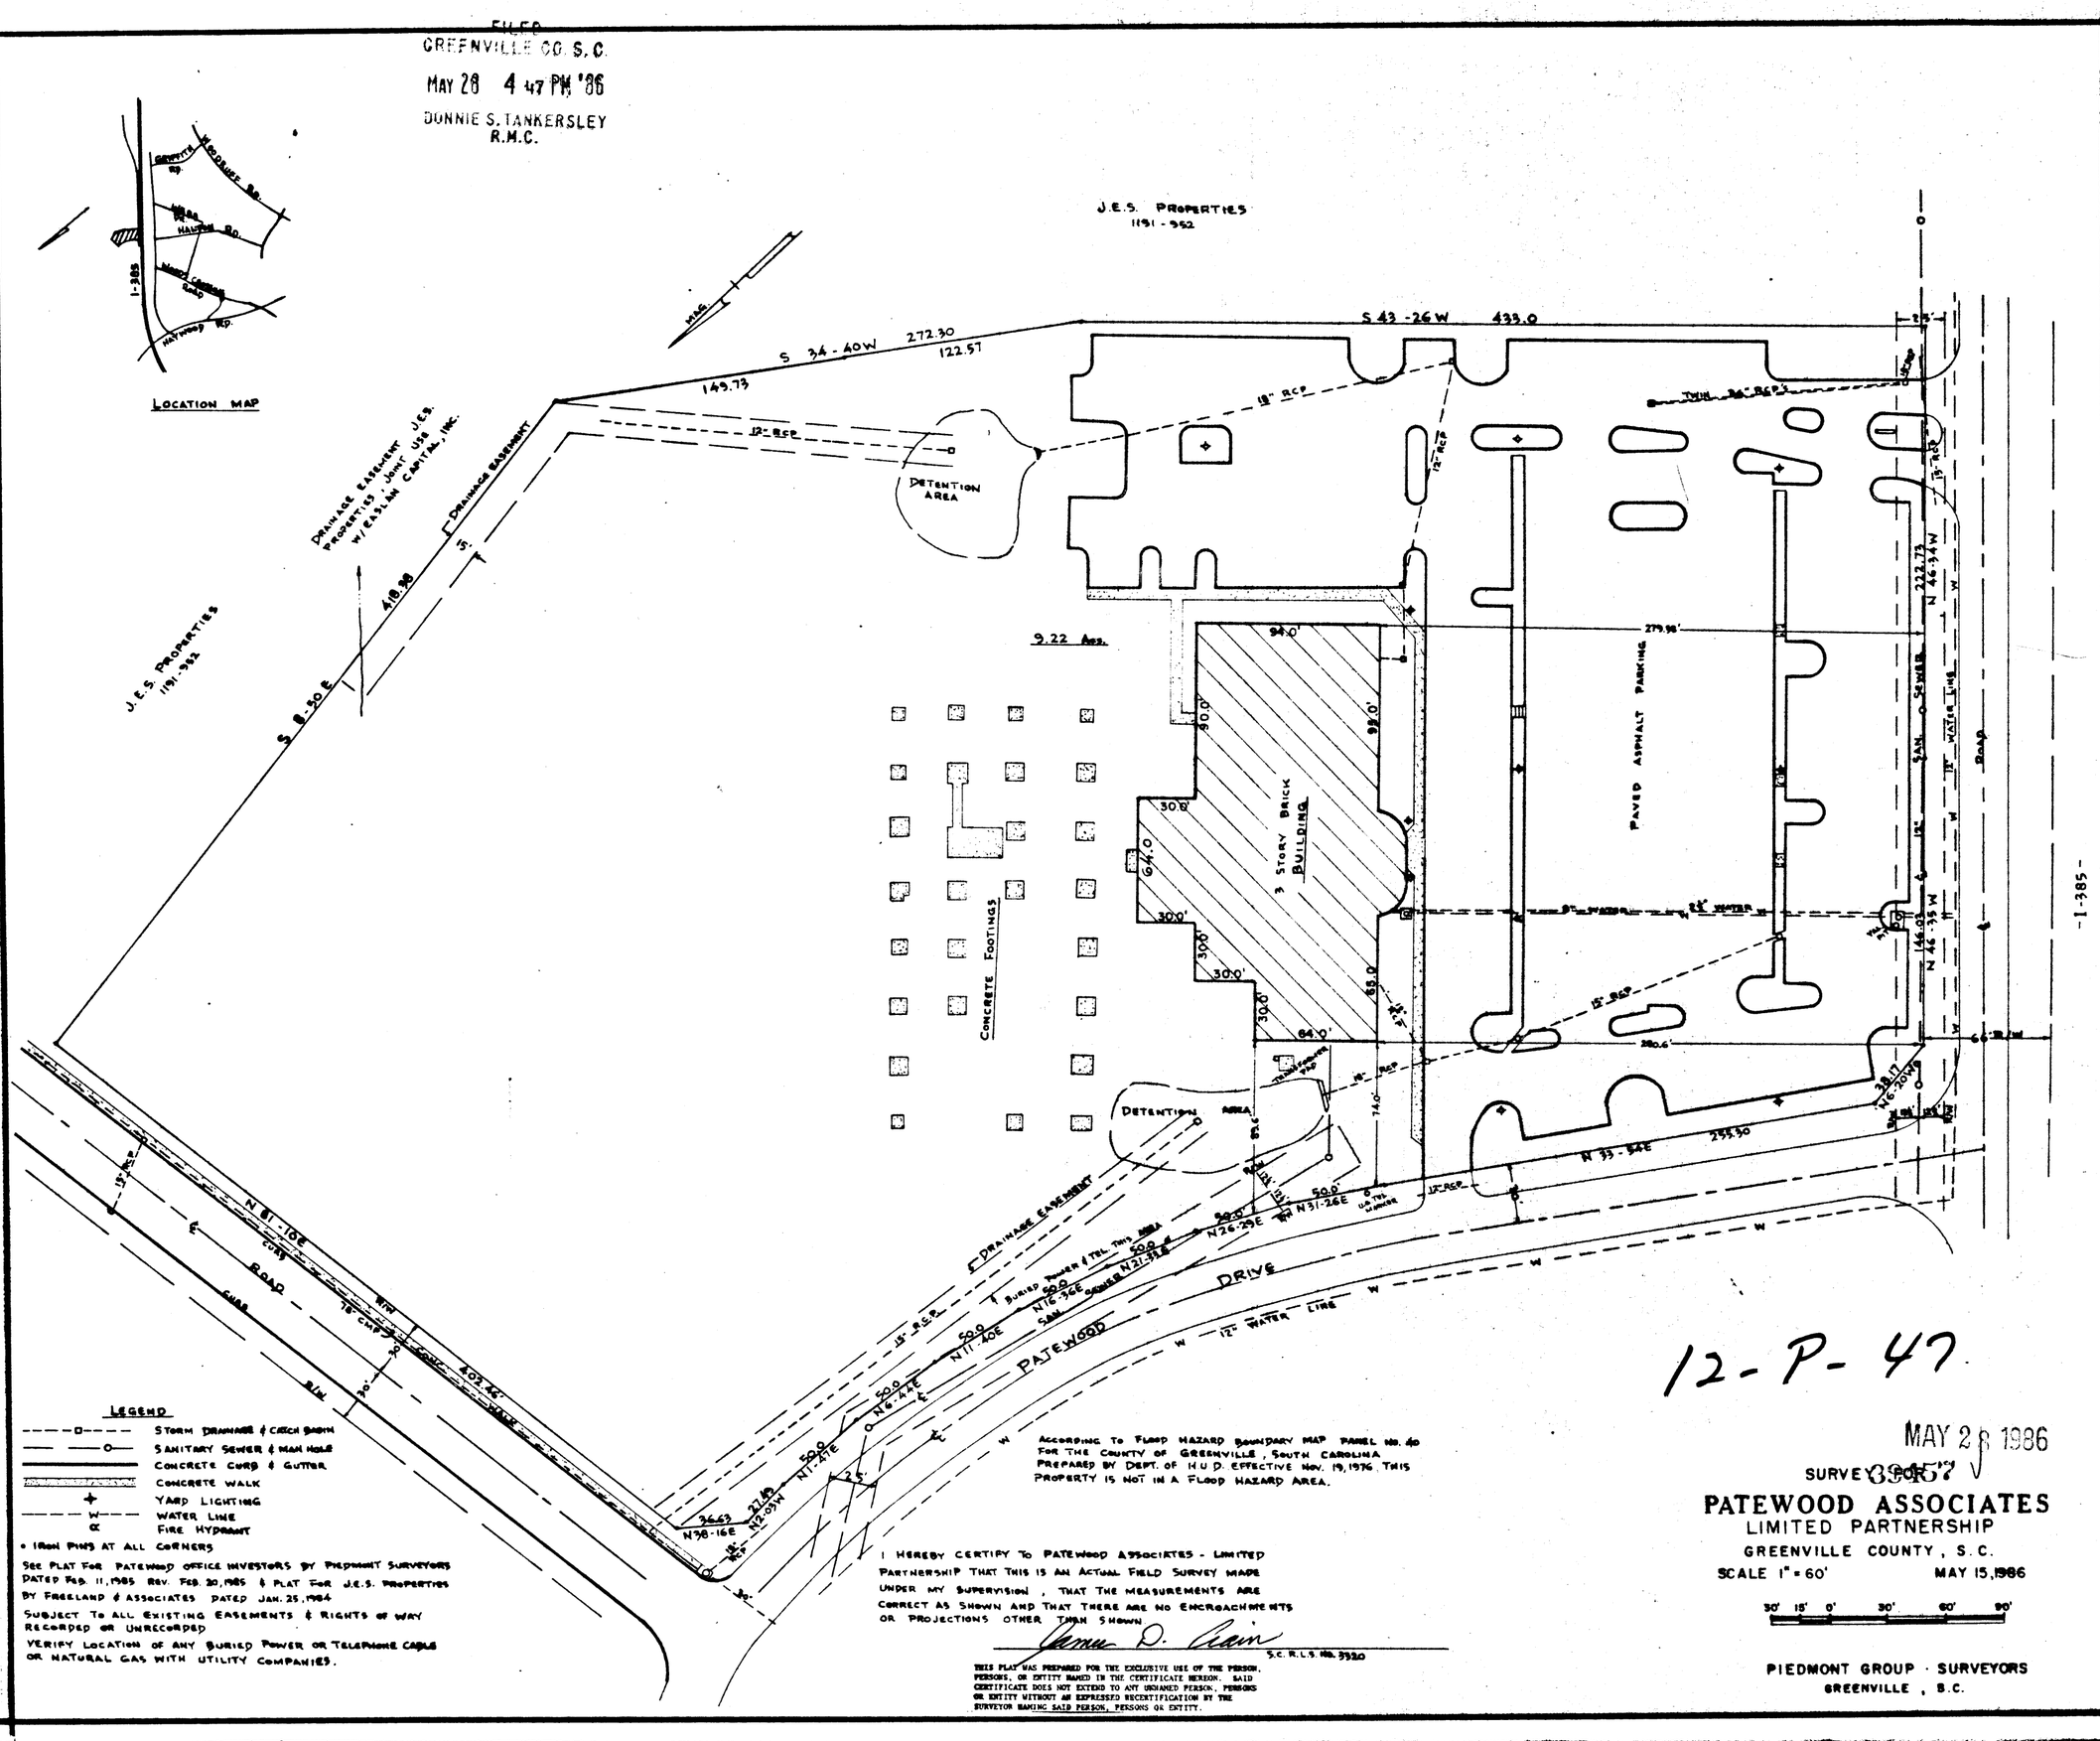




GCTO -- 3 MY28 86 635 5.00