

G22-2-6

G22-2-7

G22-2-3.2

FILED
GREENVILLE CO. S. C.

APR 24 4 23 PM '86


JOHNNIE S. TANKERSLEY
R.M.C.

G22-2-5.1

Tax Map G22-2-4

G22-2-5

G22-2-3

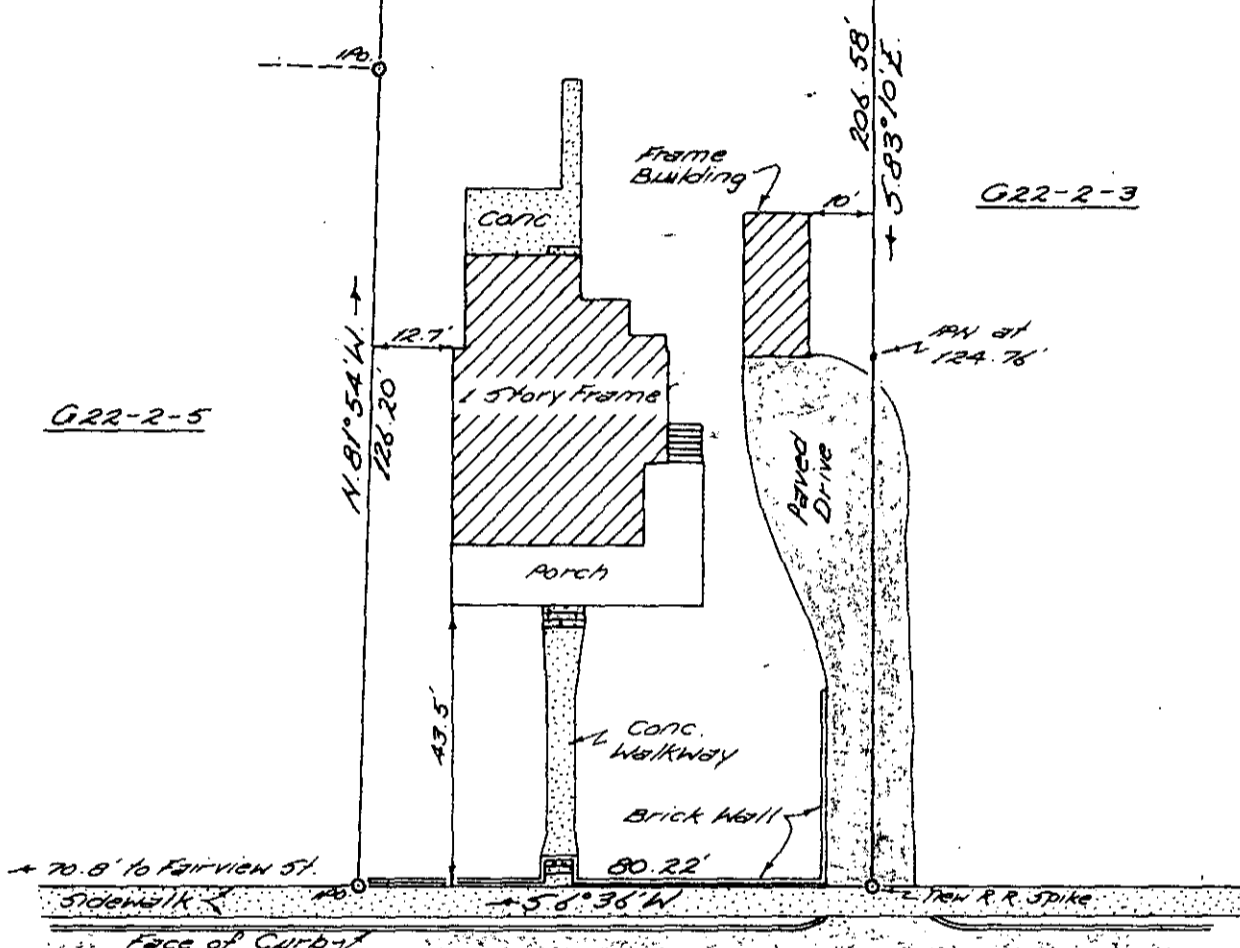

APR 24 1986

NORTH MAIN STREET

PROPERTY OF

RICHARD K. & TERESA W. HERD


Located in Greer

GREENVILLE COUNTY, SOUTH CAROLINA

SCALE: 1" = 30 FEET APRIL 18, 1986



This to certify that on April 16, 1986, I surveyed the property shown on this plat, and the same is correct, and that the property lines, walls and buildings shown thereon on the above plat, do not encroach or project on adjacent streets or property, and that no adjacent buildings or walls encroach or project on said premises and this property is not located in a Flood Plane.

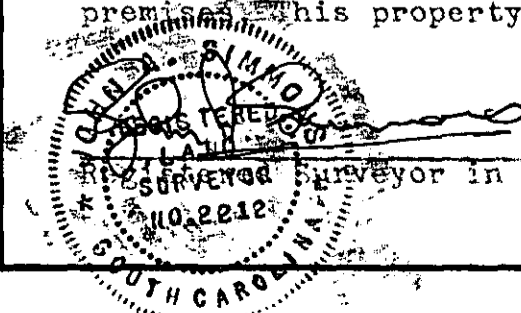

Tri-State Surveyors
109 Few Street
Greer, S. C. 29651