

FILED
 GREENVILLE CO. S.C.
 APR 25 8 53 AM '86
 BONNIE WOOD LANE
 R. B. BOUTCHER


Note: Improvements on this lot are not in a flood hazard area.

PROPERTY OF
 GLENN G. RIKARD & MARY L. RIKARD

APR 25 1986 35096

NEAR GREENVILLE, S.C.
 SCALE: 1" = 40' 21 APR 1986

12-Q-23

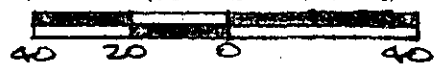

This is to certify that on the 21st day of April, 1986, I surveyed the property shown on this plat, being known as lot 16 on plat of COLLINWOOD PARK and recorded in the RMC Office Greenville County, S. C. and recorded in the RMC Office Greenville County, S. C., in Plat Book "CCC" at Page 27 and also known as PROPERTY OF GLENN G. RIKARD & MARY L. RIKARD and recorded in Plat Book _____ at Page _____; and that the proeprty lines, walls and buildings are as shown hereon, and that the walls and buildings located on said lto do not encroach or project on adjacent street or property, and that no adjacent walls or buildings encroach or project on said premises, no power lines cross this property and no visible encroachments except as shown hereon.

R. B. Boutcher
 R. B. Boutcher
 1952
 #1952
 CO. Recorder's Plat

CAROLINA SURVEYING
 112 Manly St.,
 Greenville, S. 300.8