MICROFILMED

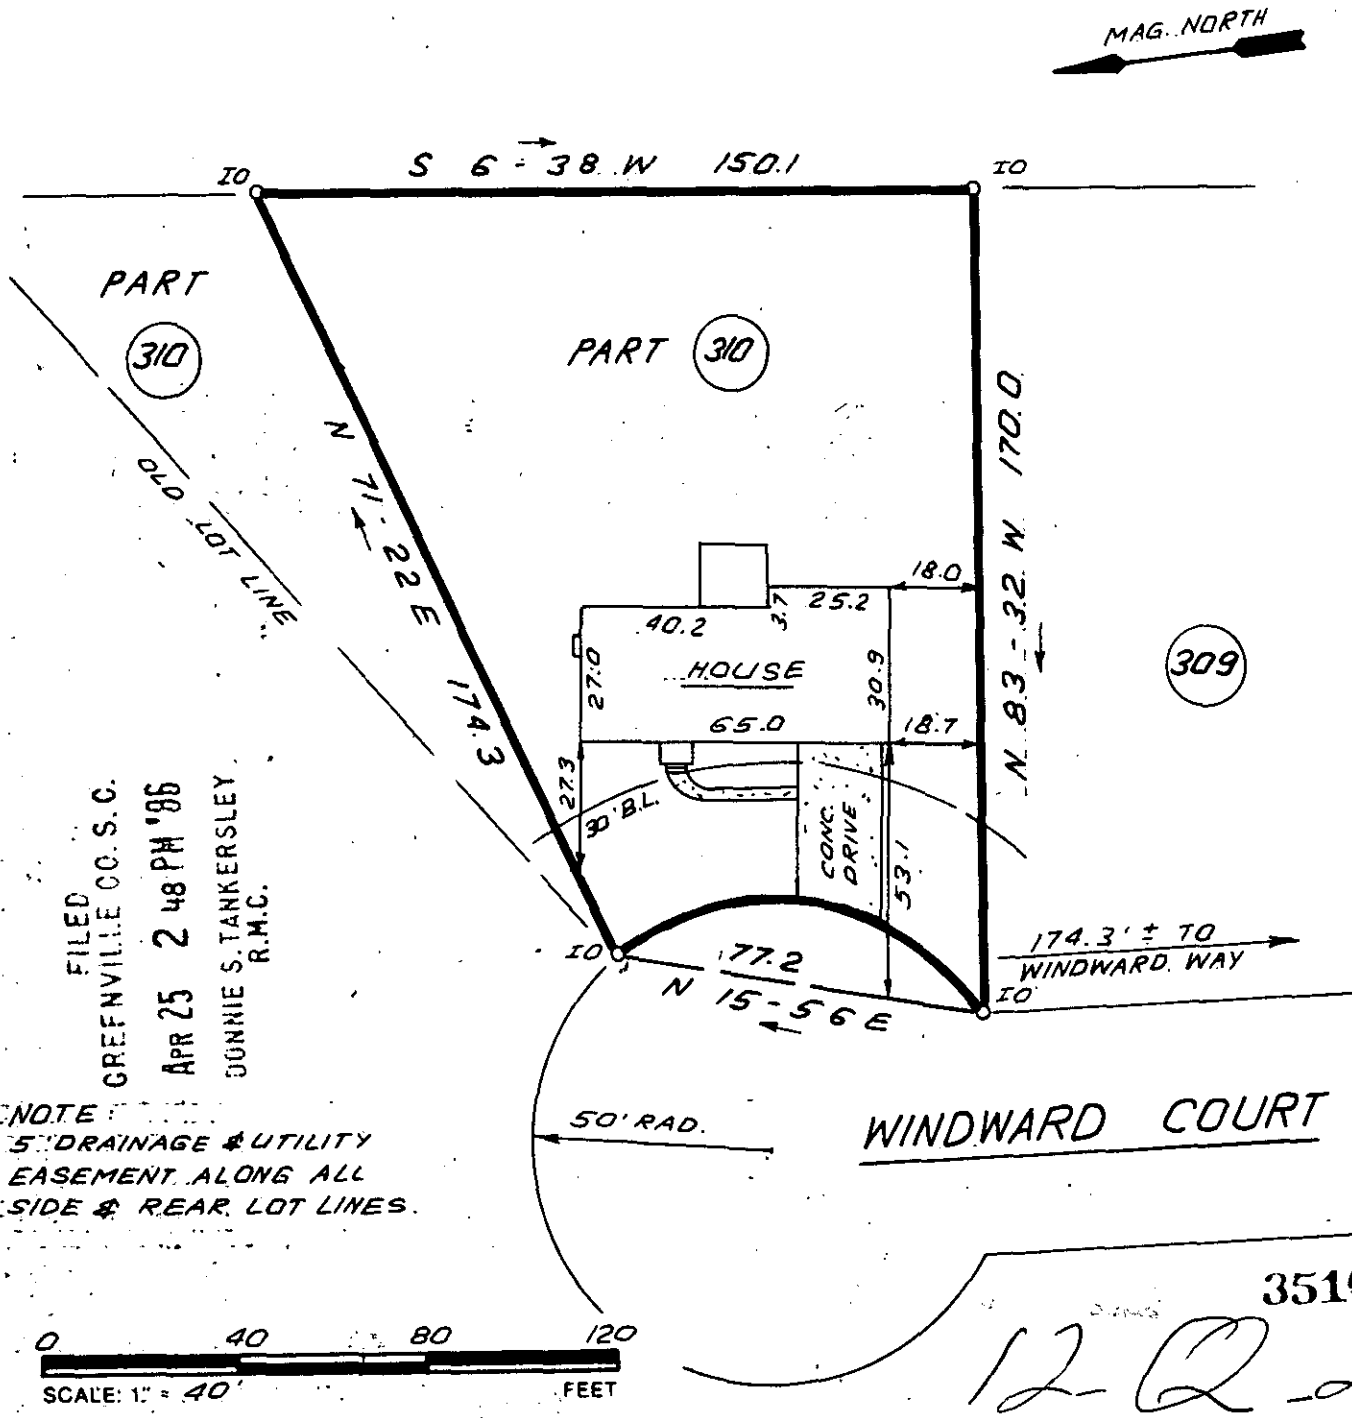

FILED
GREENVILLE CO. S.C.
APR 25 2 48 PM '86
DONNIE S. TANKERSLEY
R.M.C.

NOTE:
5' DRAINAGE & UTILITY EASEMENT ALONG ALL SIDE & REAR LOT LINES.

35101

12 Q 25

THIS IS TO CERTIFY THAT THE PROPERTY SHOWN ON THIS PLAT WAS SURVEYED UNDER MY DIRECT SUPERVISION. PROPERTY LINES AND IMPROVEMENTS SHOWN ARE LOCATED CORRECTLY AND THAT NO VISIBLE ENCROACHMENTS EXIST UNLESS OTHERWISE SHOWN. THIS *PROPERTY* IS *NOT* LOCATED IN A DESIGNATED FLOOD HAZARD AREA.

SOUTH CAROLINA REGISTERED PROFESSIONAL ENGINEER AND LAND SURVEYOR JAMES R. FREELAND

RLS: JAMES R. FREELAND
NO 4781

STATE OF SOUTH CAROLINA
GREENVILLE COUNTY

DEVENGER PLACE
SEC. 14; PT. LOT 310
PROPERTY OF
ELLEN M. WILLIAMS
JERRY R. WILLIAMS

FREELAND-CLINKSCALES & ASSOCIATES, INC.
Engineers • Land Surveyors
323 WEST STONE AVENUE
GREENVILLE, S.C.
(803) 271-4924

PLAT BOOK	108-21
DEED BOOK	1215-66
TAX MAP	540.23-1-80
PARTY CHIEF	L.T.
DRAWN	J.R.
DATE	APRIL-15-86
DWG. NO.	15004

THE PRINT MACHINE, INC. N73428

2 AP 25 86 430
3.00 CI
3.00 CI