


FILED
GREENVILLE CO. S.C.

APR 29 2 30 PM '86


PHIL S. TANKERSLEY
R.M.C.

APR 29 1986

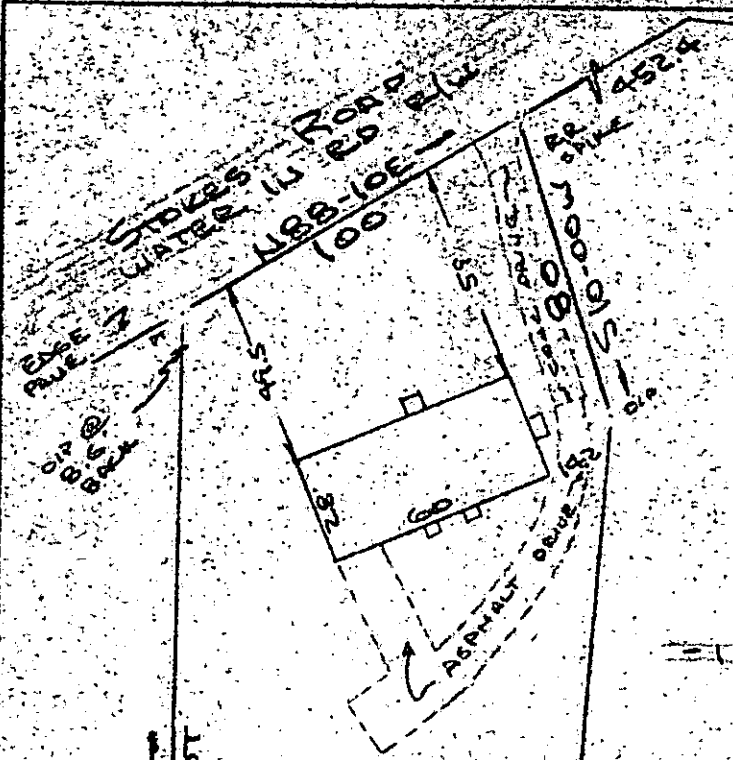

Note: Improvements on this lot are not in a flood hazard area.

PROPERTY OF
 LESTER FRANK HELMS
 &
 BETTY M. HELMS
 NEAR SIMPSONVILLE GREENVILLE CO. S.C.
 SCALE: 1" = 50' 23 APR 1986

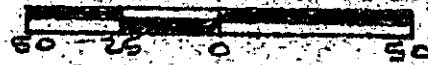

This is to certify that on the 23rd day of April, 1986, I surveyed the property shown on this plat, being known as lot 1 - A (0.75 ac) on plat of PROPERTY OF LEVIS L. GILSTRAP and recorded in the RMC Office Greenville County, S. C., in Plat Book " 4 - E " at Page 131, and that the property lines, walls and buildings are as shown hereon, and that the walls and buildings located on said lot do not encroach or project on adjacent street or property, and that no adjacent walls or buildings encroach or project on said premises, no power lines cross this property and no visible encroachments except as shown hereon.

APR 29 1986

12-Q-54

35515

R. B. BRUCE

R. B. Bruce, RMC # 1952

CAROLINA SURVEYING
 112 Manly St.
 Greenville, S. C.

Recordable Plat